


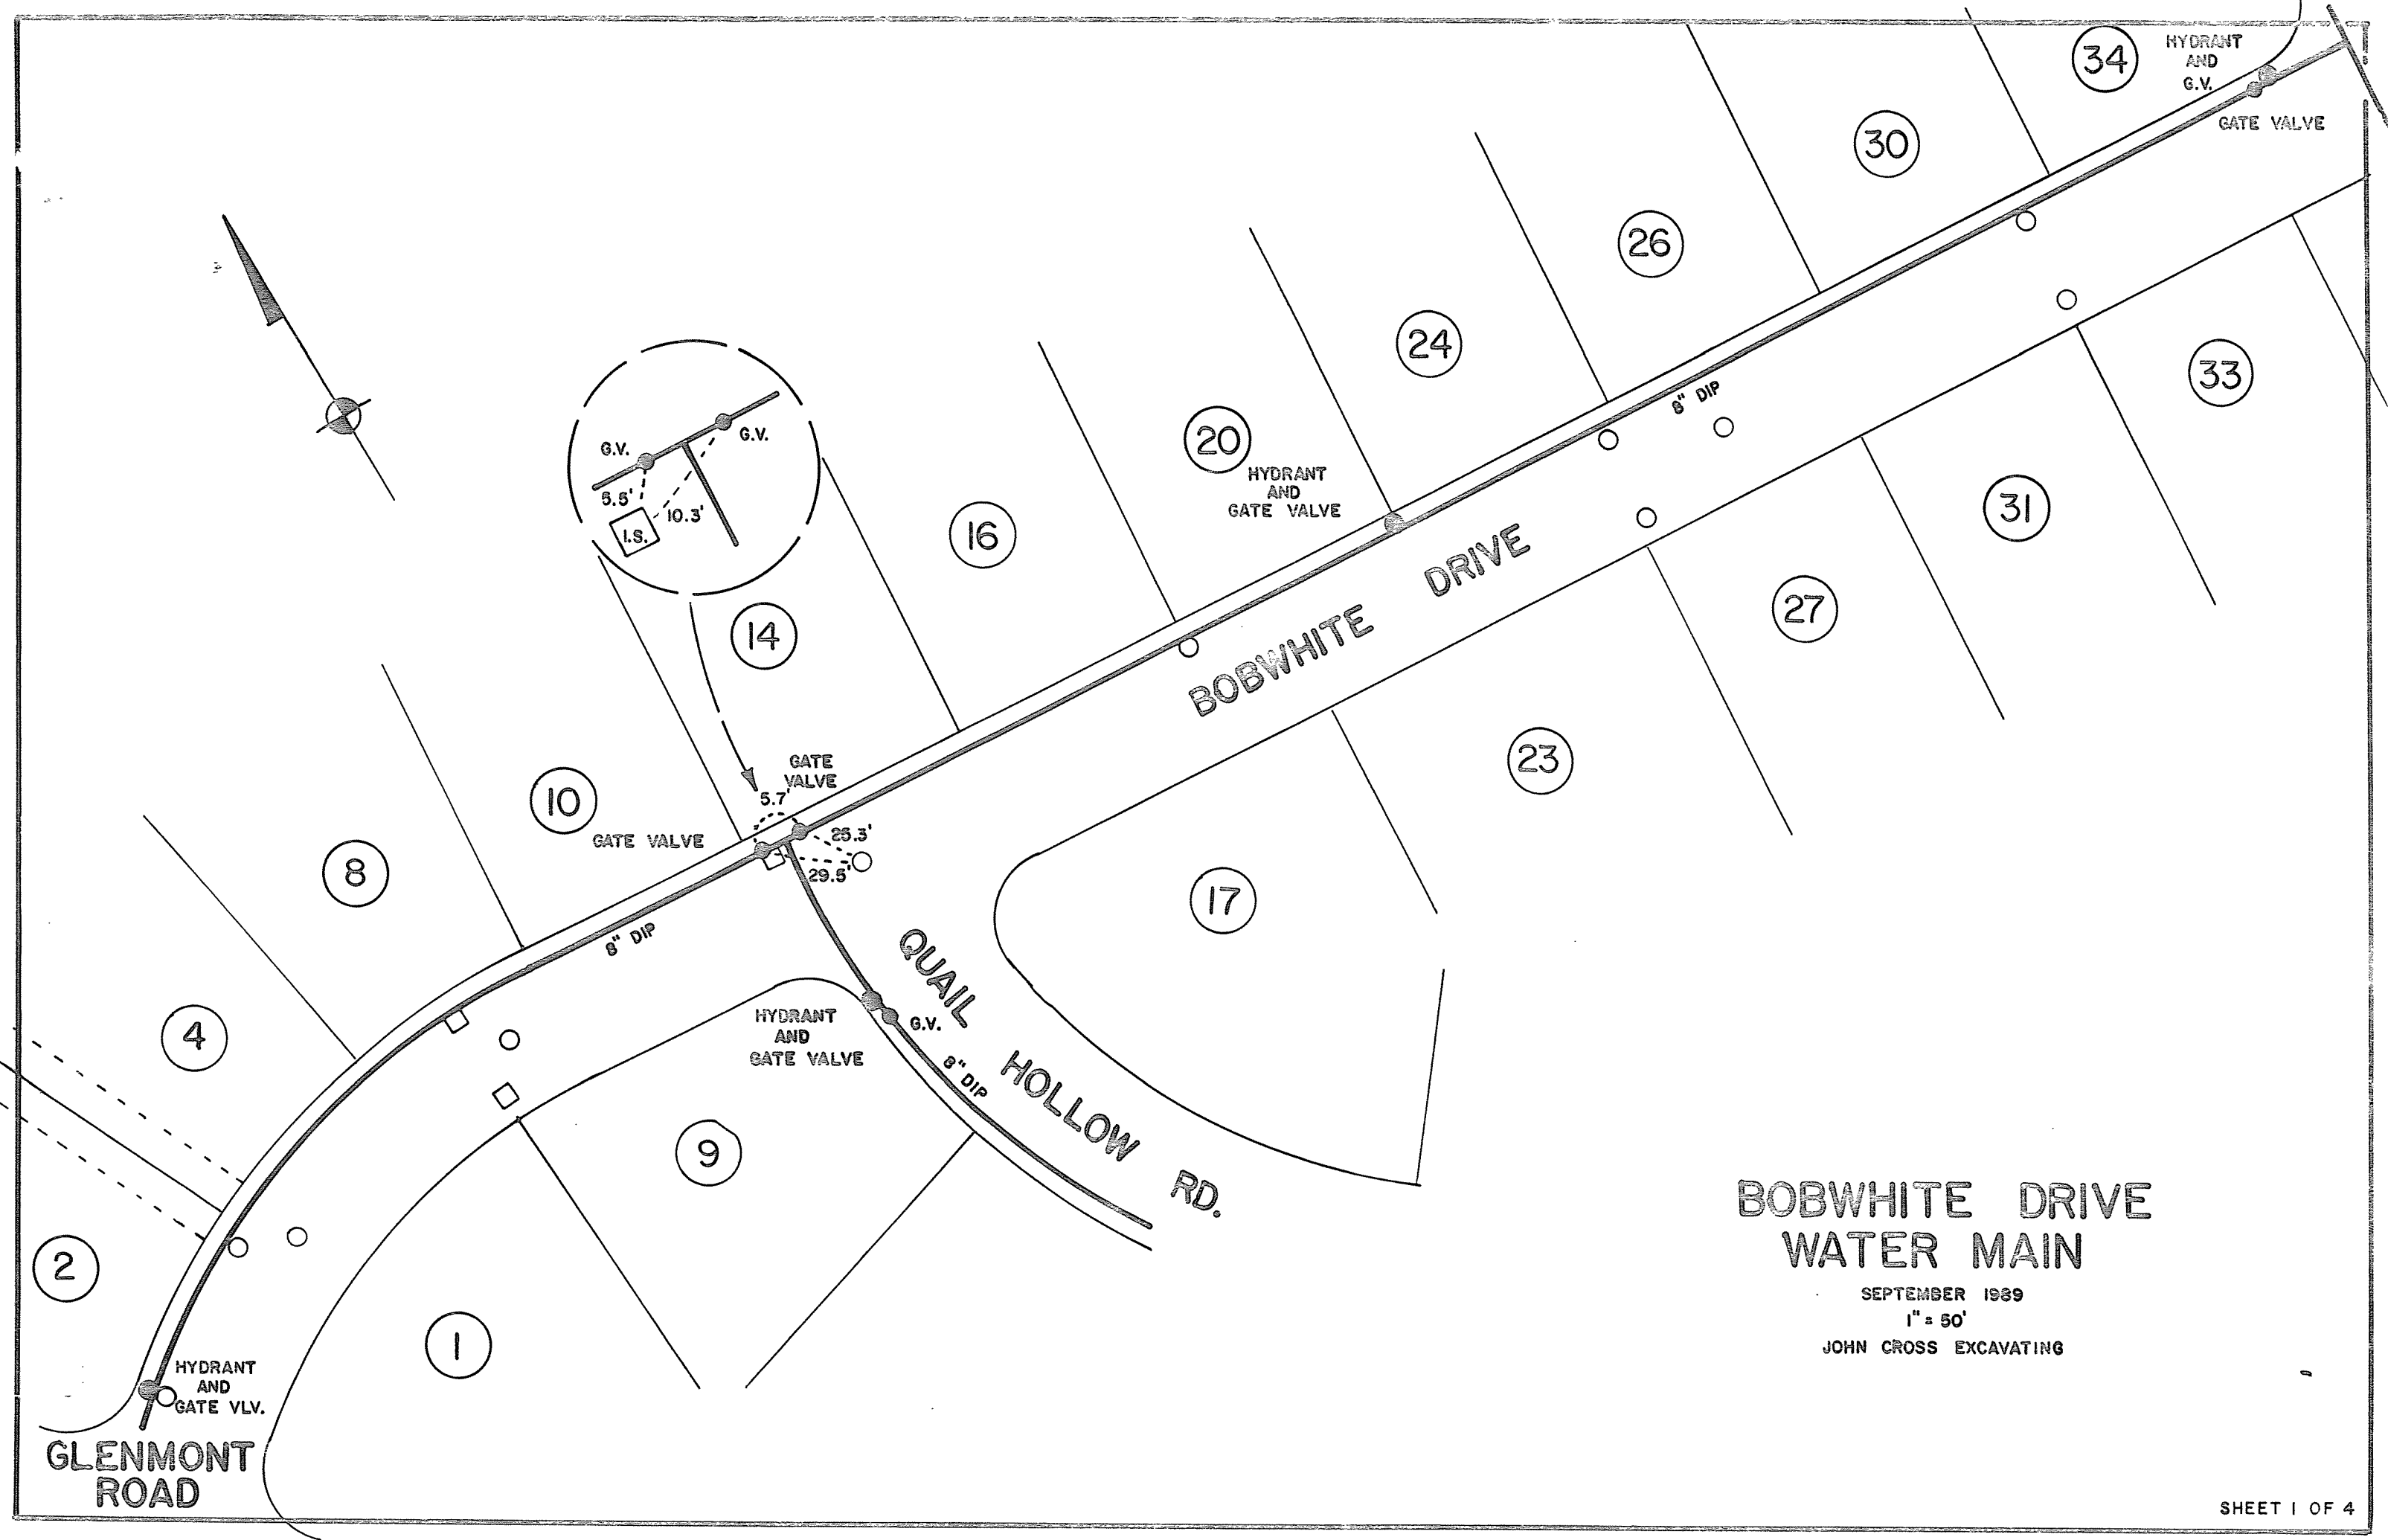

BOBWHITE DRIVE
WATER MAIN

SEPTEMBER 1989
1" = 50'
JOHN CROSS EXCAVATING

GLENMONT
ROAD