


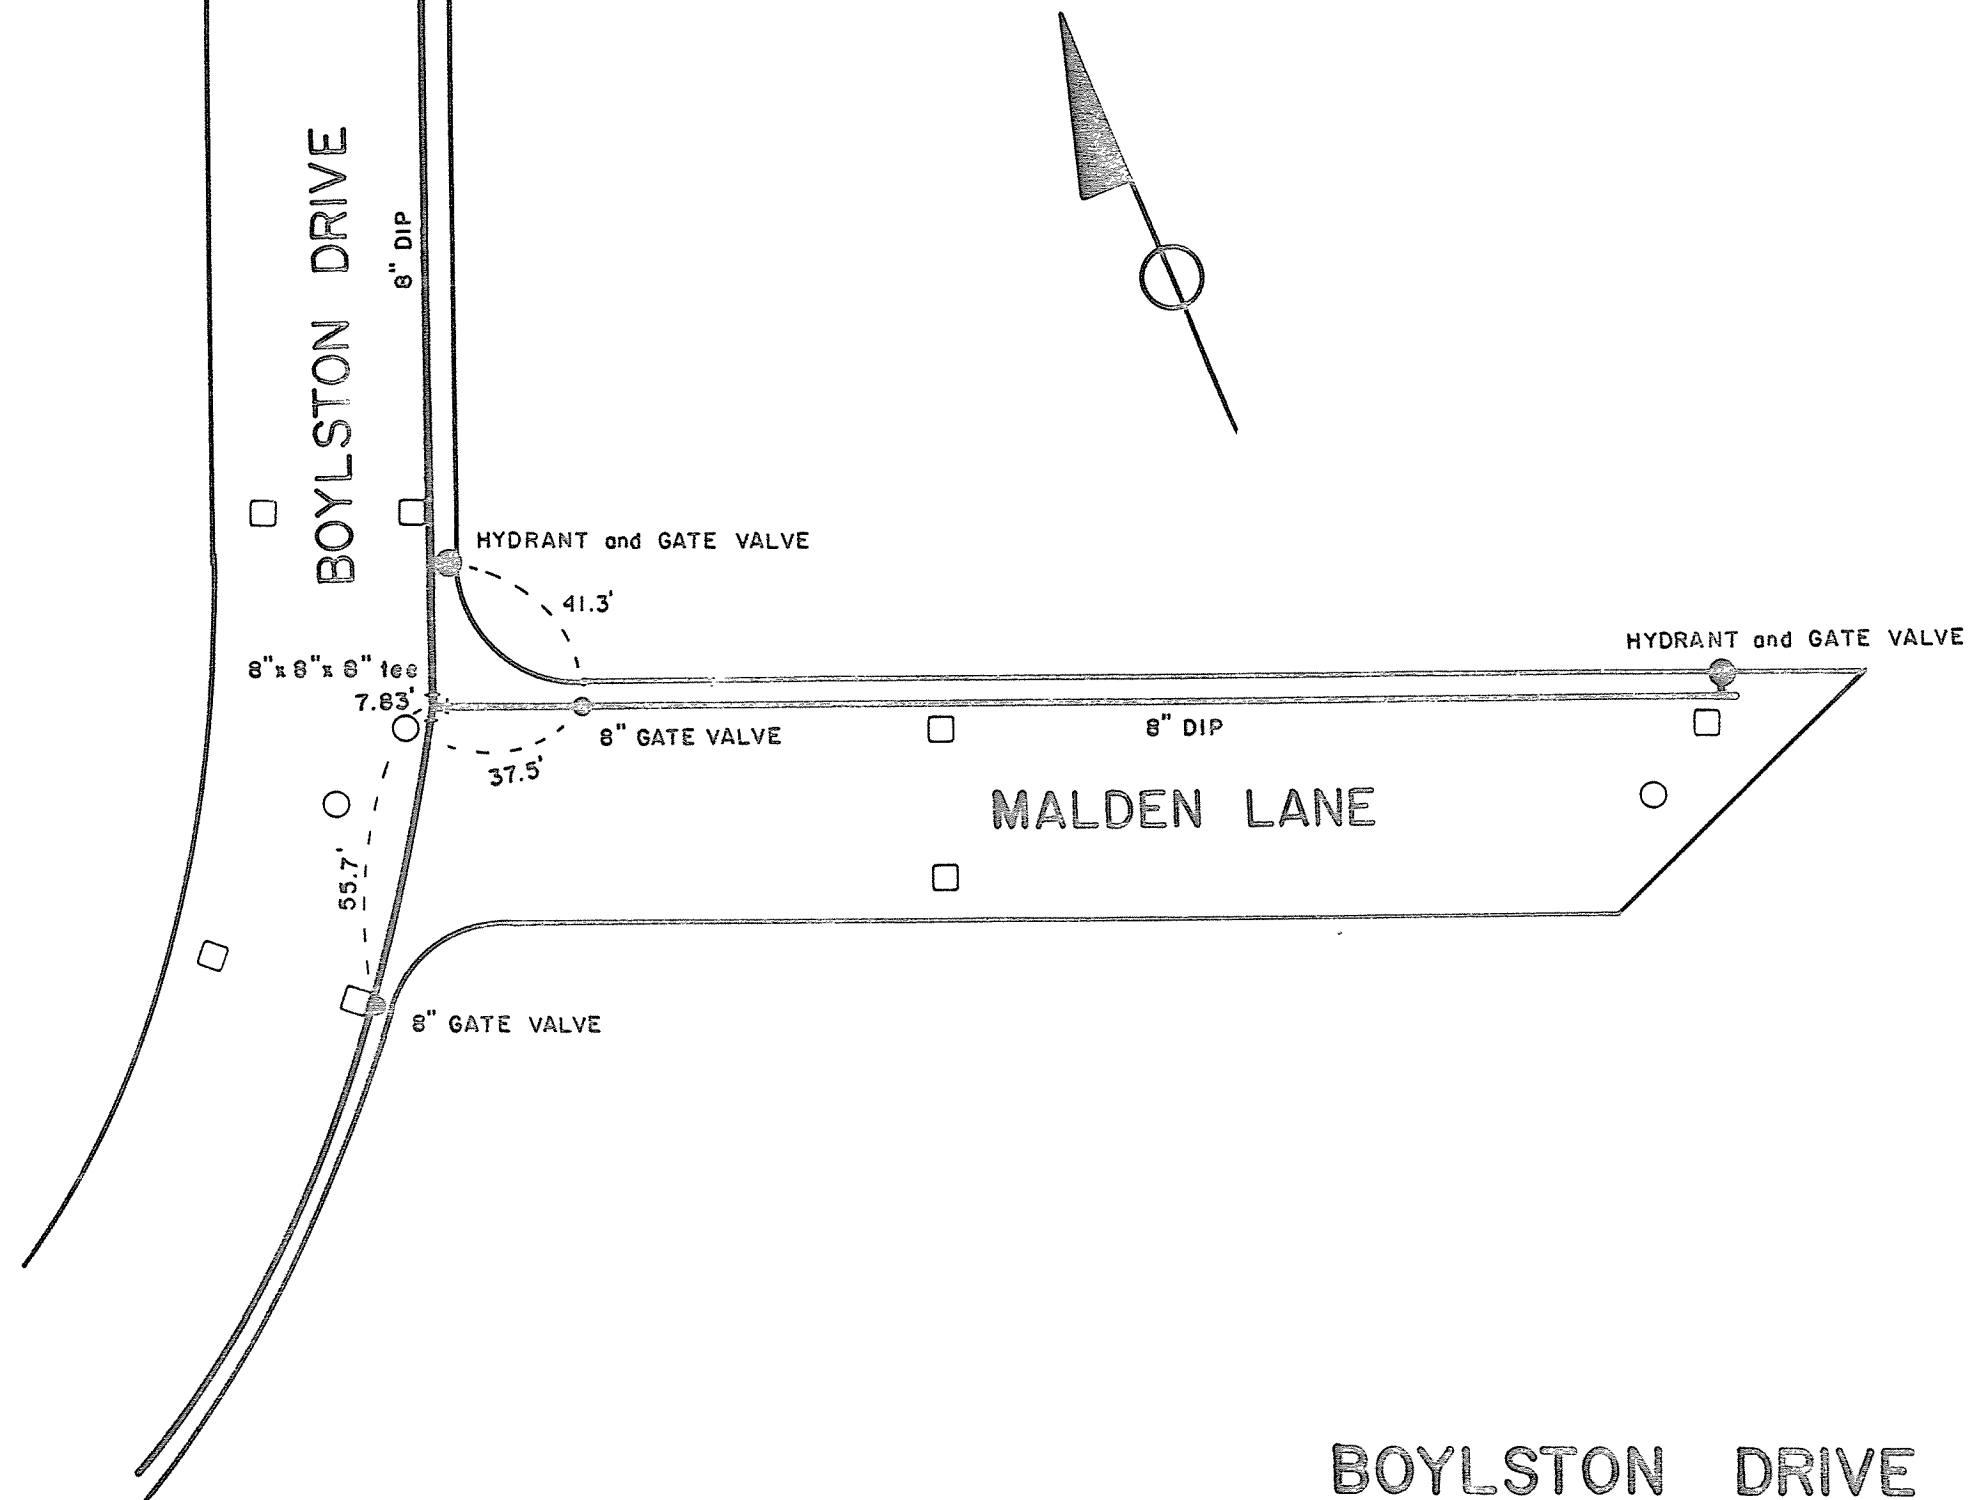

BOYLSTON DRIVE
MALDEN LANE

WATER MAIN
SEPTEMBER 1937

1" = 40'