


LEGEND

- CATCH BASIN
- MANHOLE
- ⊕ HYDRANT
- GATE VALVE
- ⊥ TEE
- ▲ THRUST BLOCK
- W— WATER MAIN

NOTE:
ALL WATER MAINS SHALL BE 8" DUCTILE IRON.

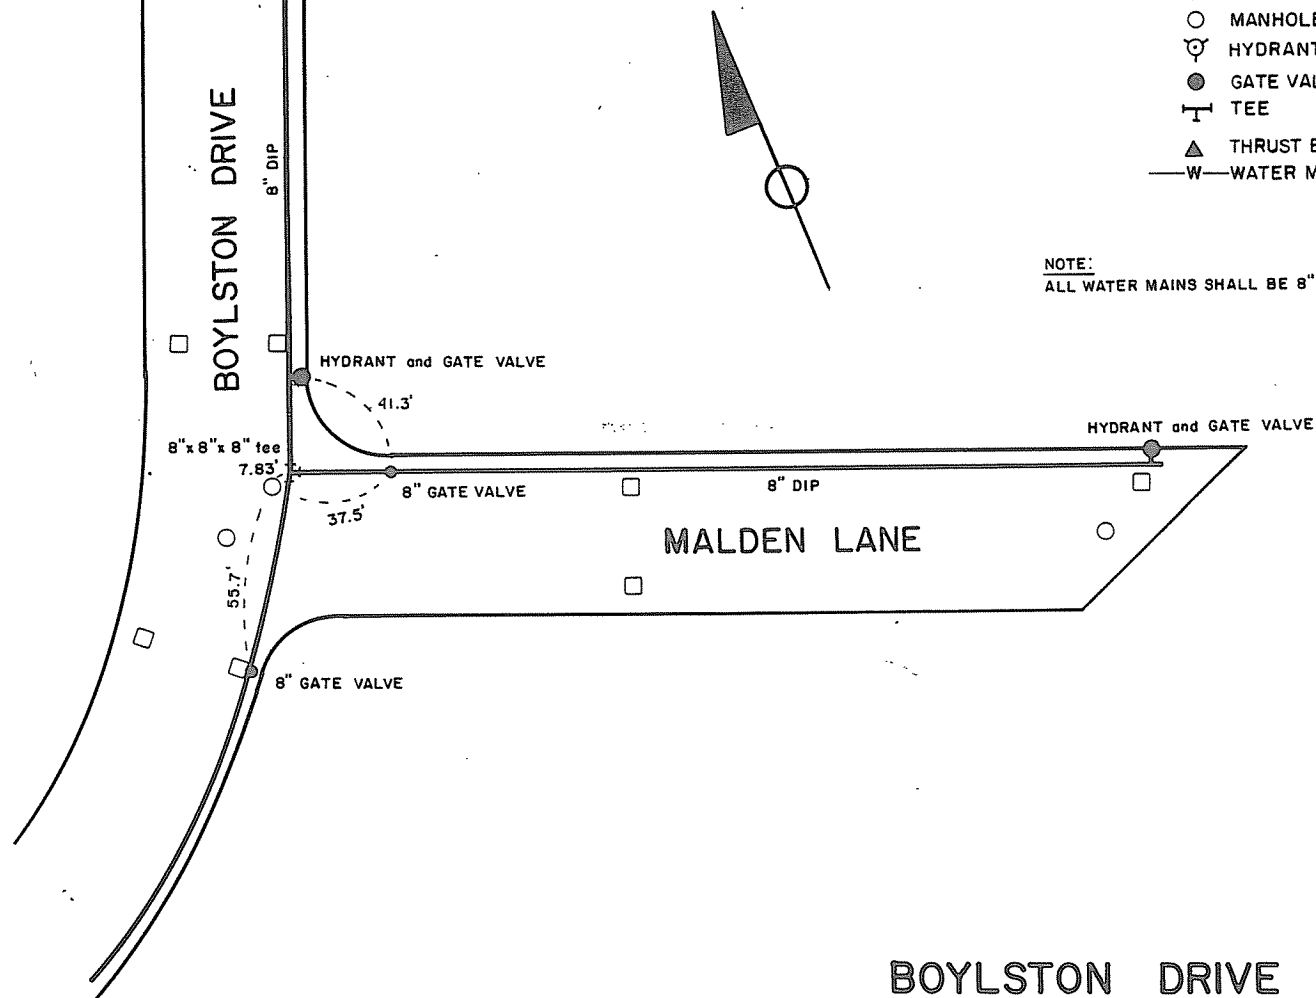

BOYLSTON DRIVE
MALDEN LANE

WATER MAIN

SEPTEMBER 1987

1" = 40'