


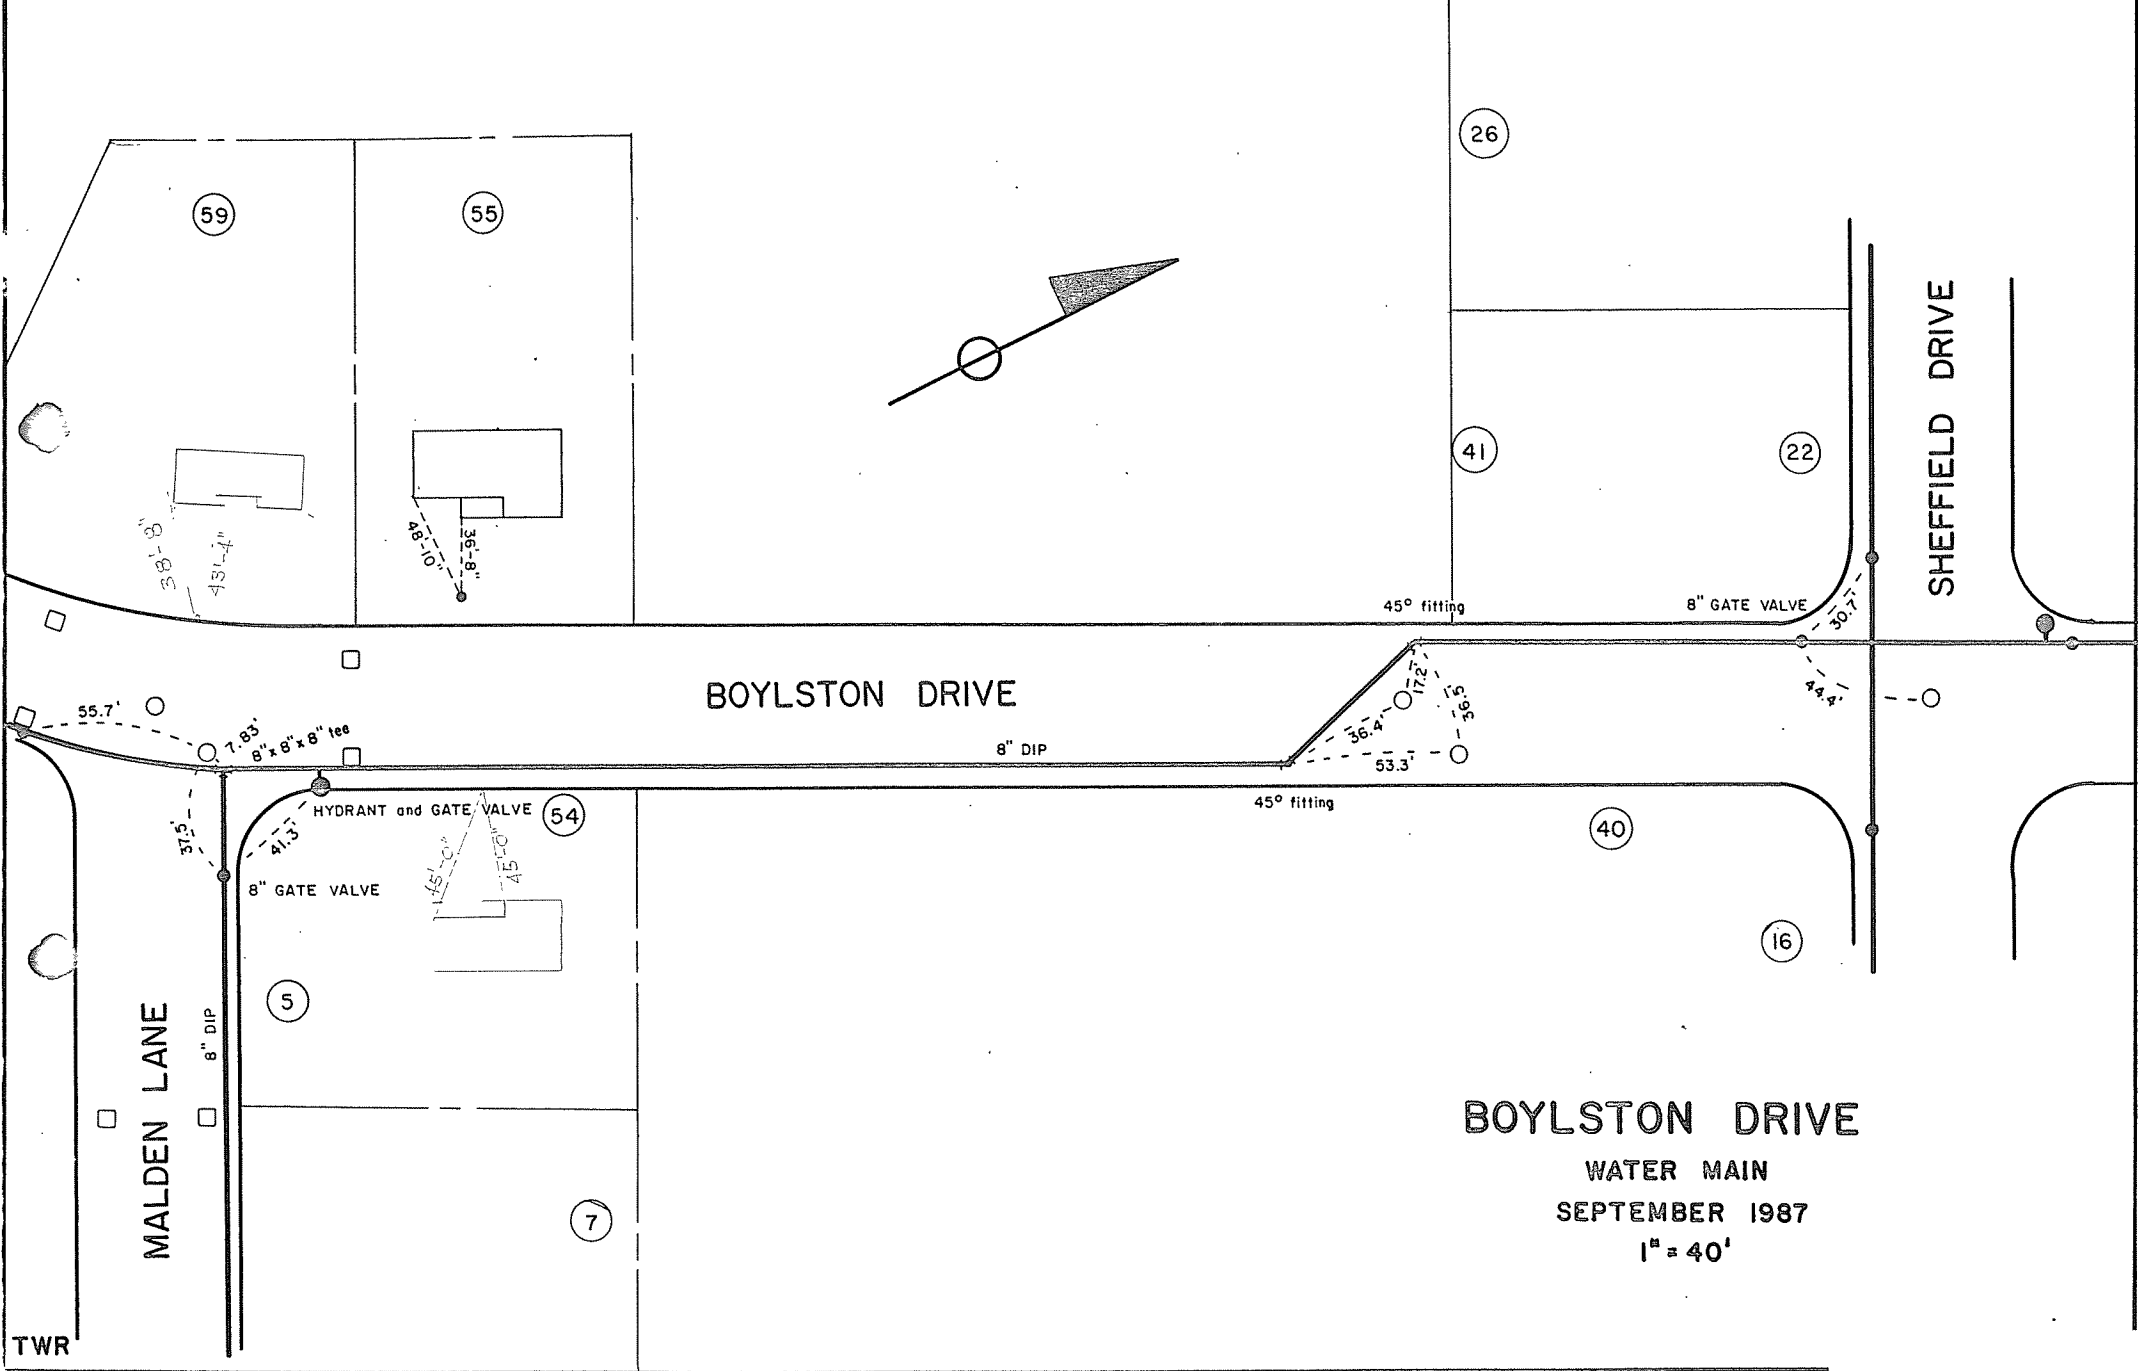

BOYLSTON DRIVE

SHEFFIELD DRIVE

MALDEN LANE

BOYLSTON DRIVE

WATER MAIN

SEPTEMBER 1987

1" = 40'

TWR