

DOVER DRIVE

BOYLSTON


DRIVE

SHEFFIELD DRIVE

BOYLSTON DRIVE  
"LAURALANA HEIGHTS"  
WATER DISTRICT NO. 1  
TOWN OF BETHLEHEM

RECORD OF INSTALLATION  
TOWN OF BETHLEHEM ENGINEERING  
DEPARTMENT

SCALE: 1"=50'  
JANUARY, 1982  
DWN. BY: PDH

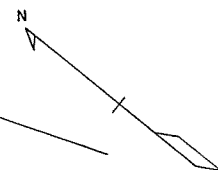

7

8

14

18

20

24

28

9

11

15

19

25

50

41

43-6

46

38

40

56

28' 0"

110' 0"

SAN. M.H.

