


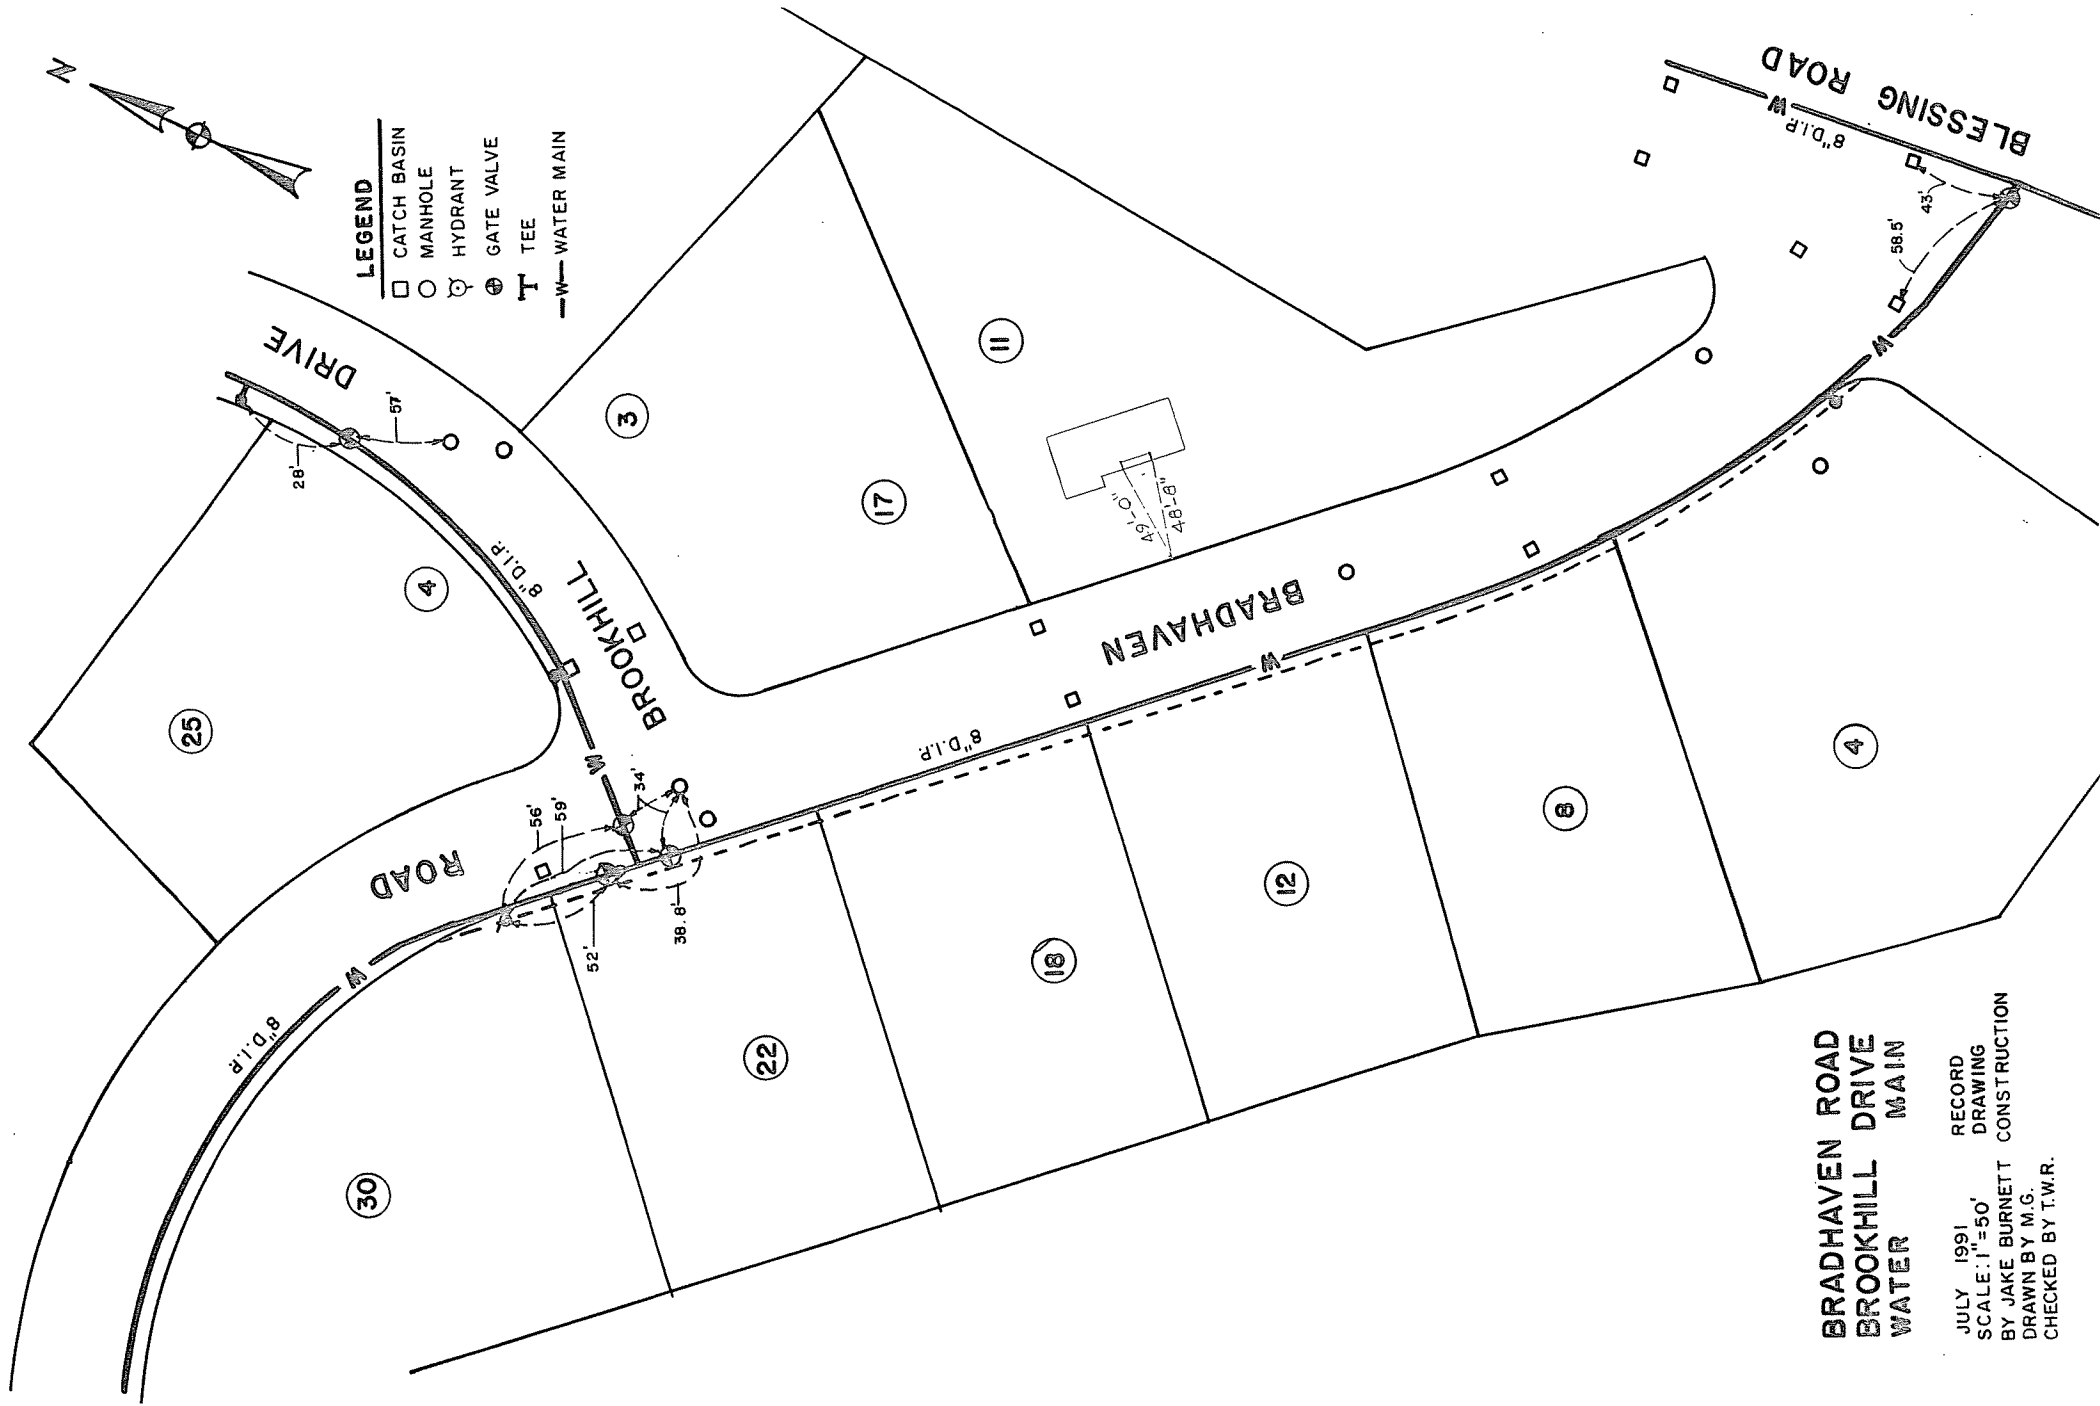

BRADHAVEN ROAD **BROOKHILL DRIVE** **WATER MAIN**

JULY 1991
 SCALE: 1"=50'
 BY JAKE BURNETT
 DRAWN BY M.G.
 CHECKED BY T.W.R.

RECORD
 DRAWING
 CONSTRUCTION