


12' TO RODDED
PLUG.

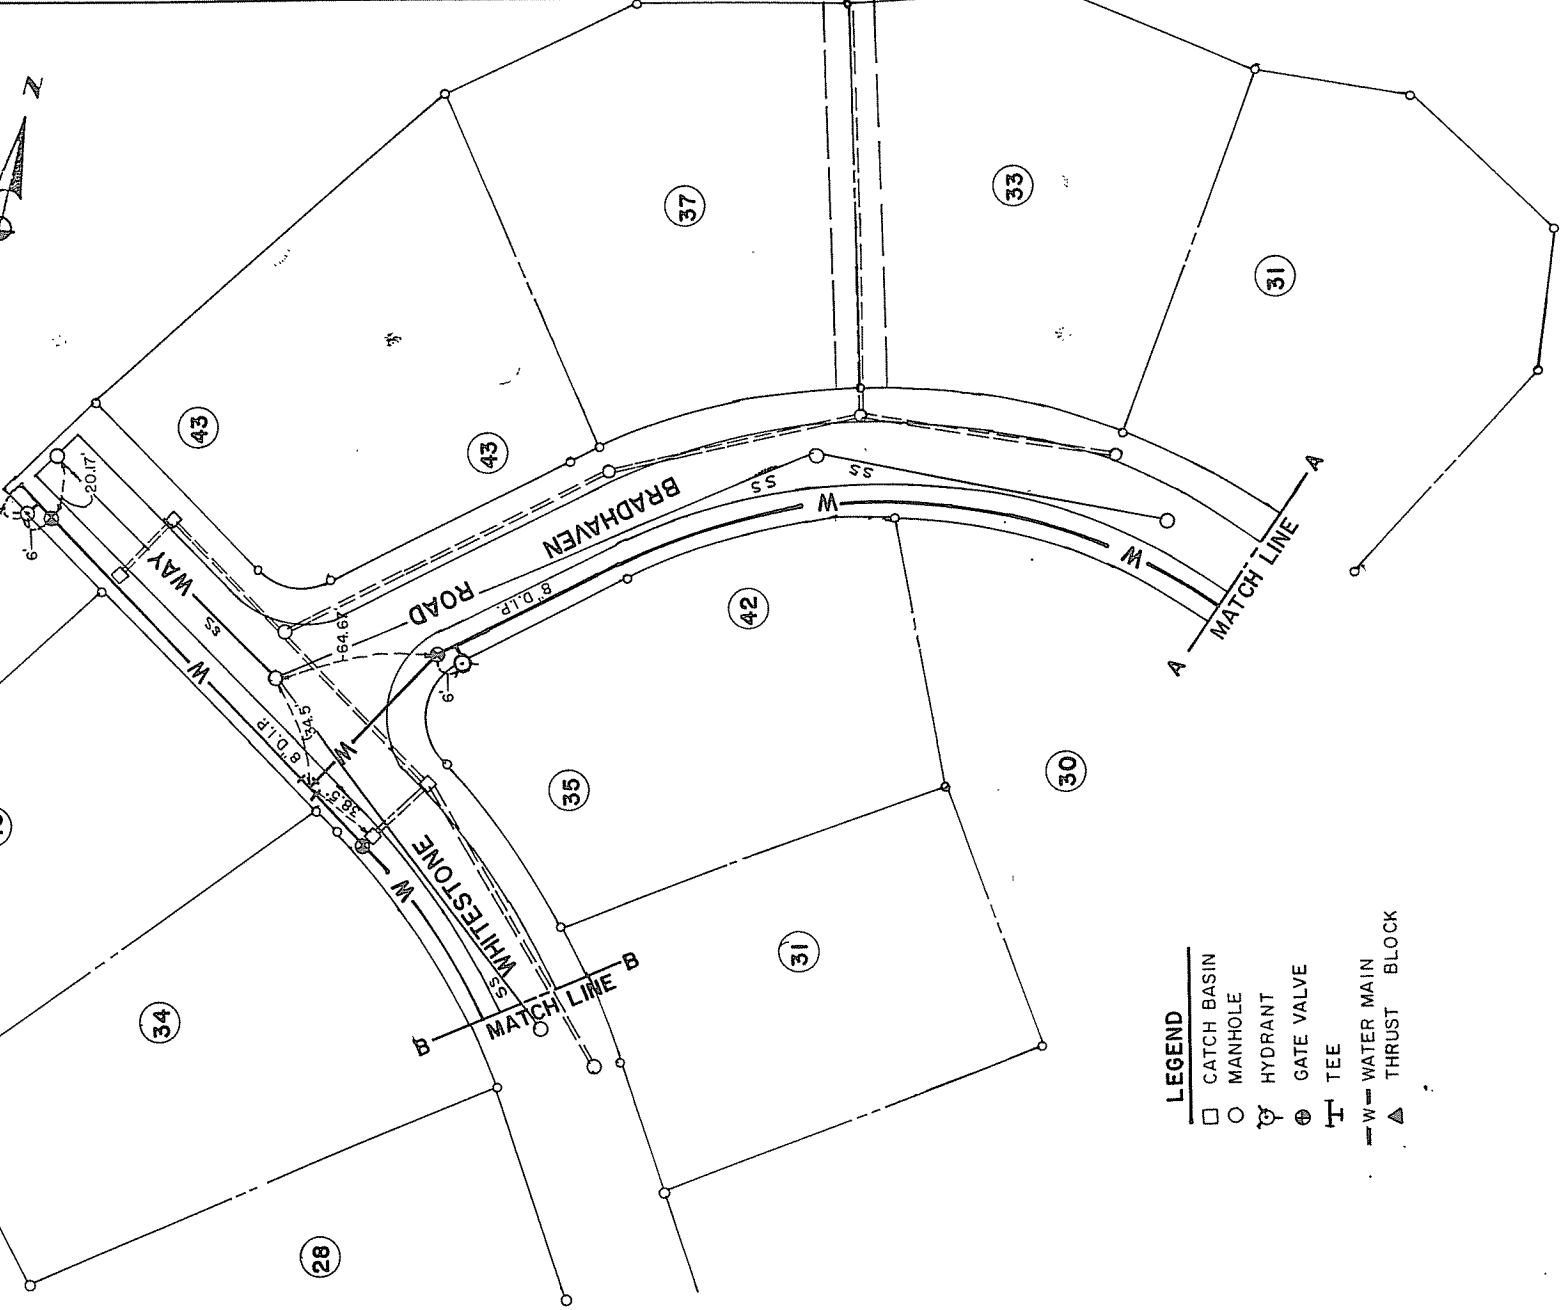

LEGEND

- CATCH BASIN
- MANHOLE
- ⊕ HYDRANT
- ⊕ GATE VALVE
- ⊕ TEE
- W — WATER MAIN
- ▲ THRUST BLOCK

BRADHAVEN ROAD
WHITESTONE WAY
WATER MAIN
AUG. 23, 1994
SCALE: 1" = 50'
RECORD
DRAWING
Breakhill Sub. Div.