

BRIGHTONWOOD ROAD
WATER DISTRICT NO.1
TOWN OF BETHLEHEM
RECORD OF INSTALLATION
TOWN OF BETHLEHEM ENGINEERING
DEPARTMENT
SCALE: 1"=50' NOVEMBER, 1980
DWN. BY: PDH

N
↗

ROAD

BUSH

FEURA

BRIGHTONWOOD


ROAD

4


26

28

32

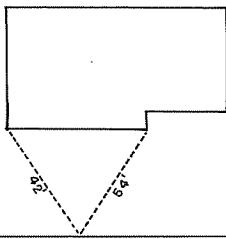

5

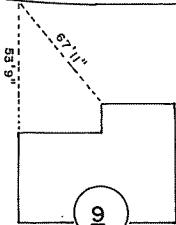

9

13

17

21

25

29