


BRIGHTONWOOD ROAD
WATER DISTRICT NO. 1
TOWN OF BETHLEHEM

RECORD OF INSTALLATION
TOWN OF BETHLEHEM ENGINEERING
DEPARTMENT

SCALE: 1"=50'
DECEMBER, 1982
DWN. BY: PDH

SUSSEX ROAD

→ N

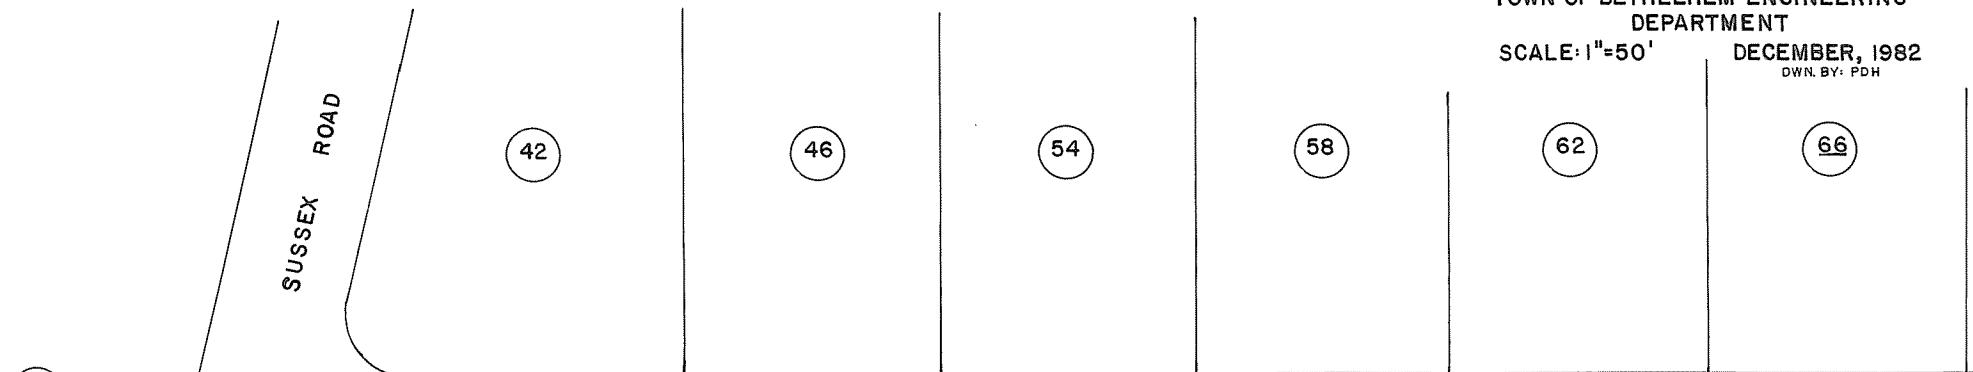

BRIGHTONWOOD ROAD

