


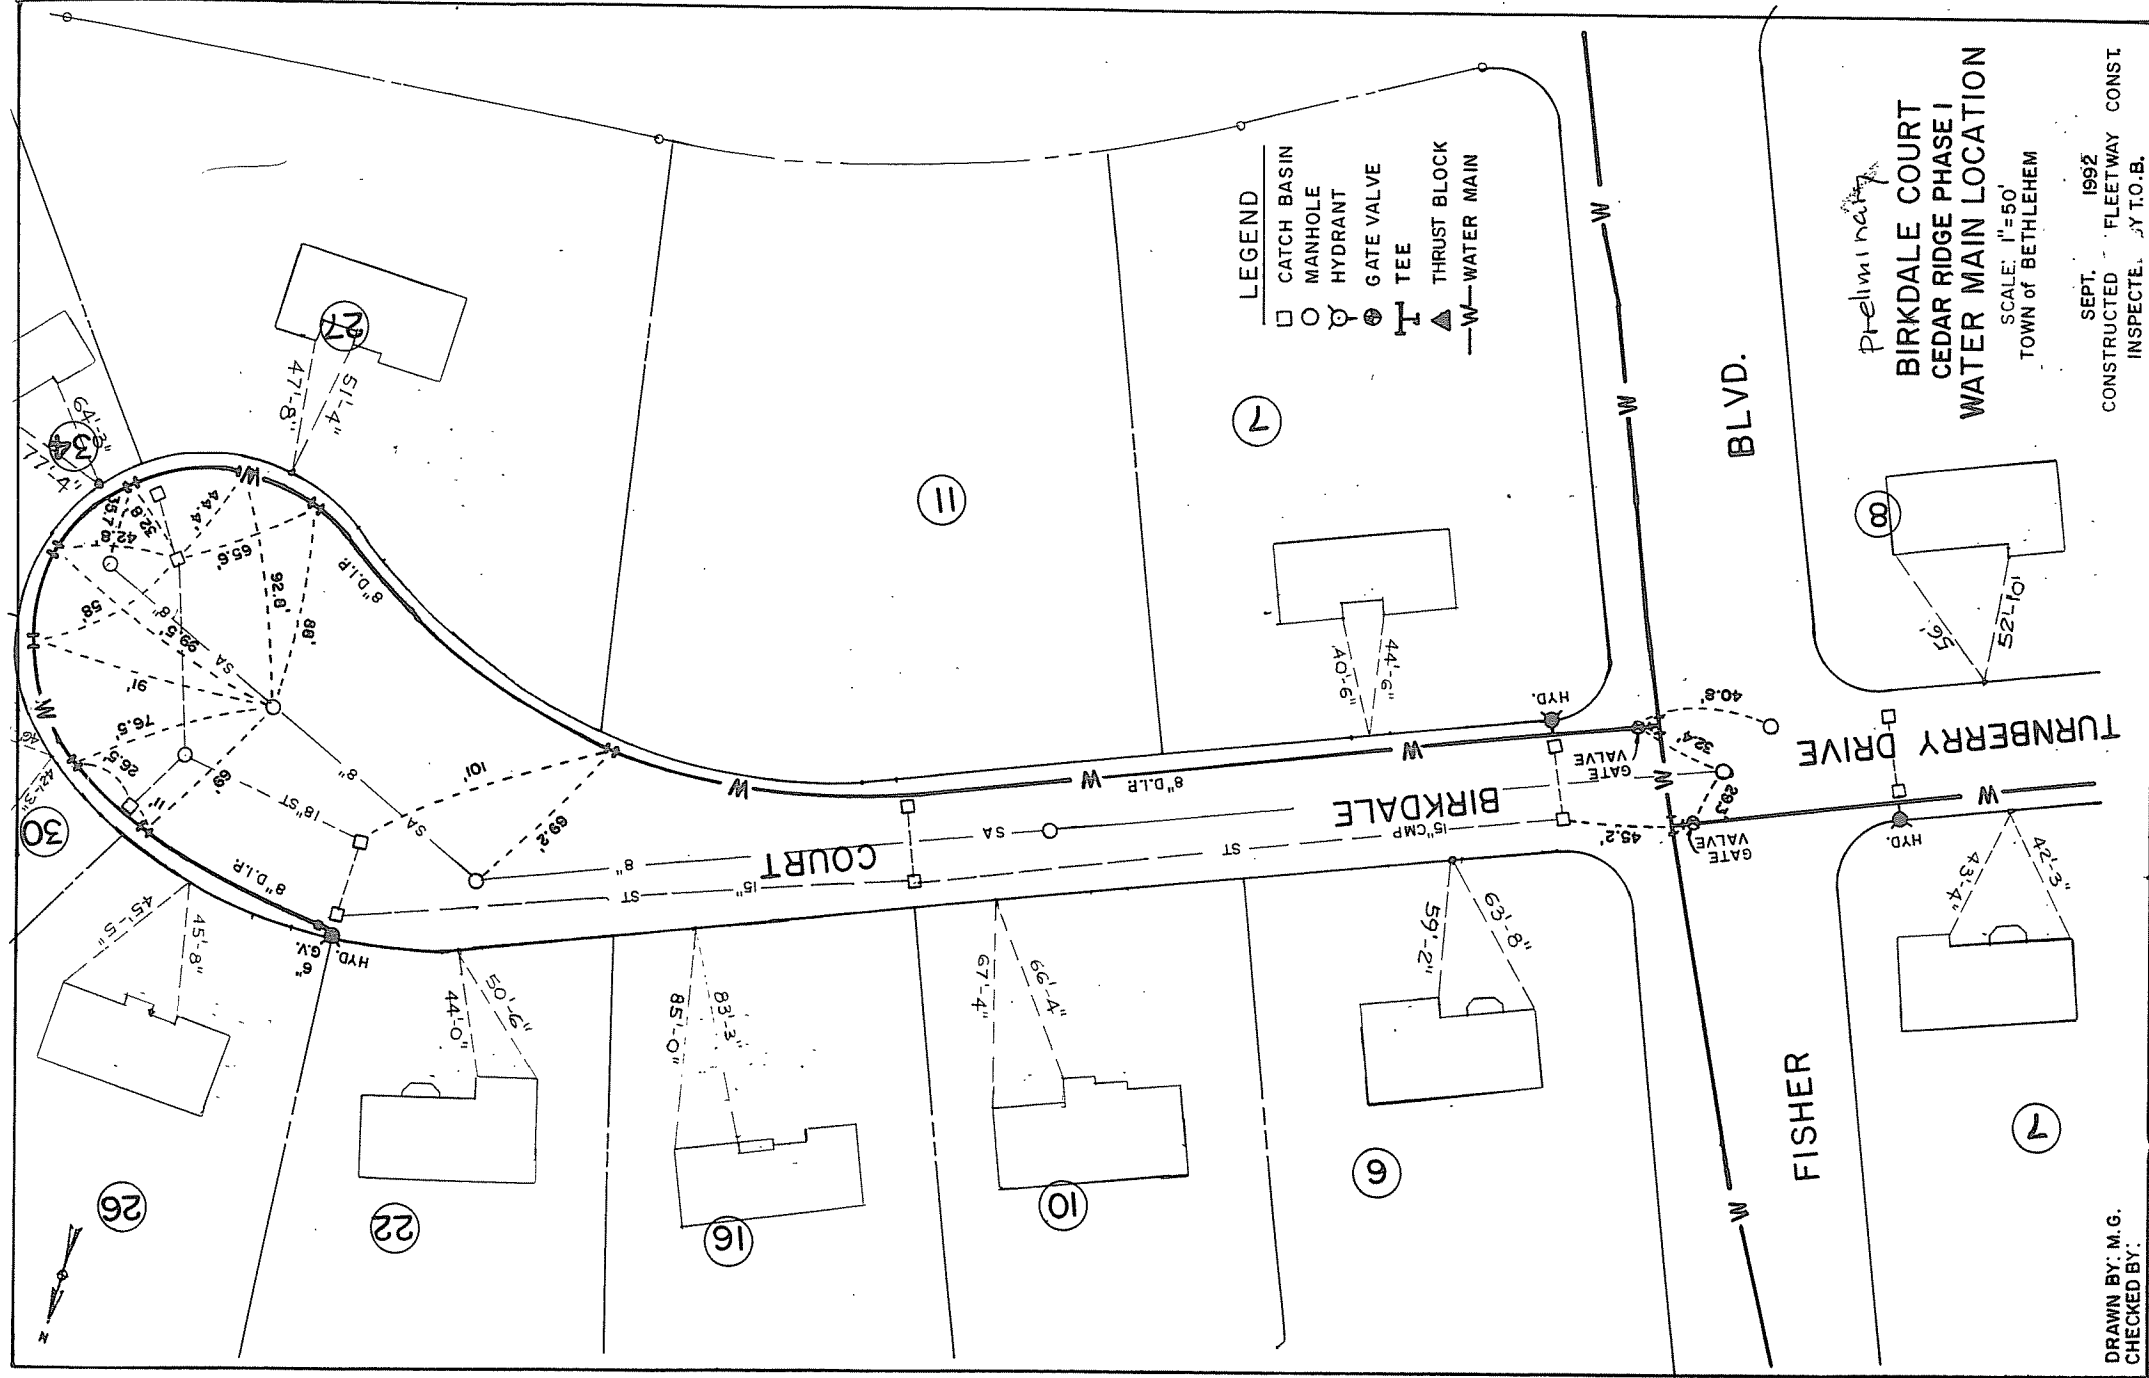

- LEGEND**
- CATCH BASIN
 - MANHOLE
 - ⊕ HYDRANT
 - ⊕ GATE VALVE
 - ⊕ TEE
 - ⊕ THRUST BLOCK
 - W— WATER MAIN

Preliminary

**BIRKDALE COURT
CEDAR RIDGE PHASE I
WATER MAIN LOCATION**

SCALE: 1"=50'
TOWN OF BETHLEHEM

SEPT. 1992
CONSTRUCTED BY FLEETWAY CONST.
INSPECTED BY I.O.B.
Cedar Ridge Phase I

DRAWN BY: M.G.
CHECKED BY: