


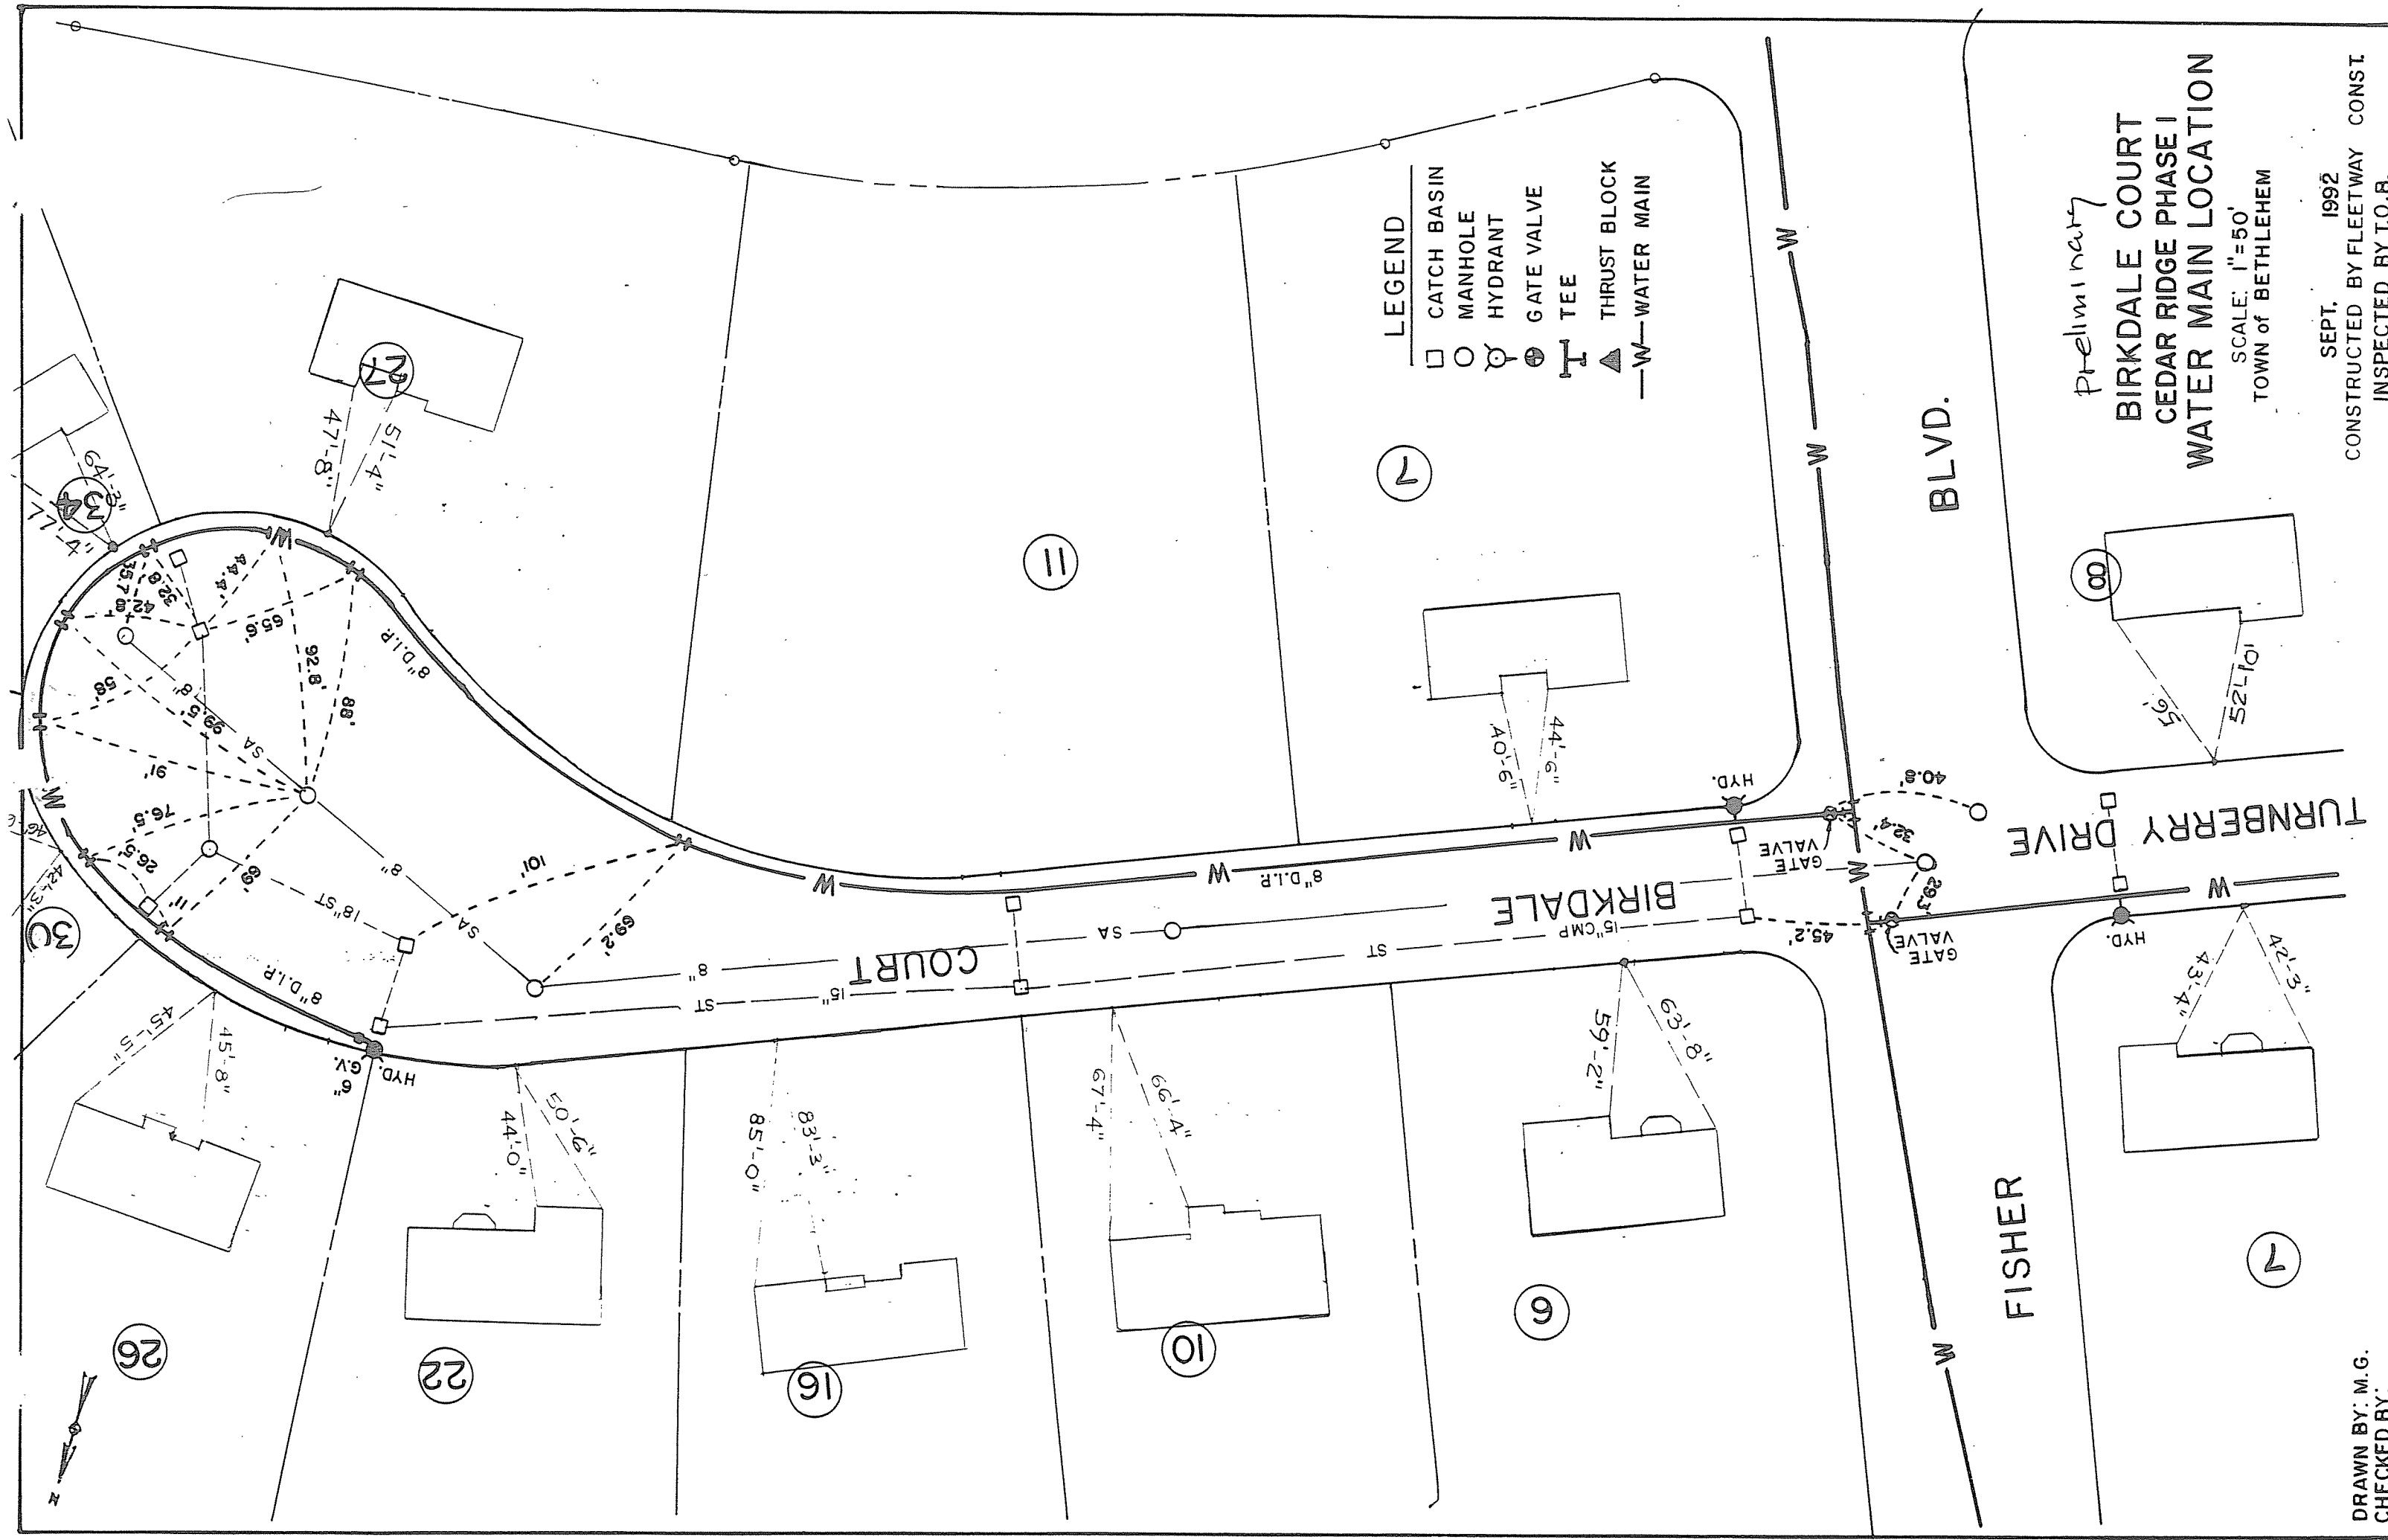

DRAWN BY: M.G.
CHECKED BY:

preliminary
BIRKDALE COURT
CEDAR RIDGE PHASE I
WATER MAIN LOCATION
SCALE: 1"=50'
TOWN of BETHLEHEM

SEPT. 1992
CONSTRUCTED BY FLEETWAY CONST
INSPECTED BY T.O.B.