


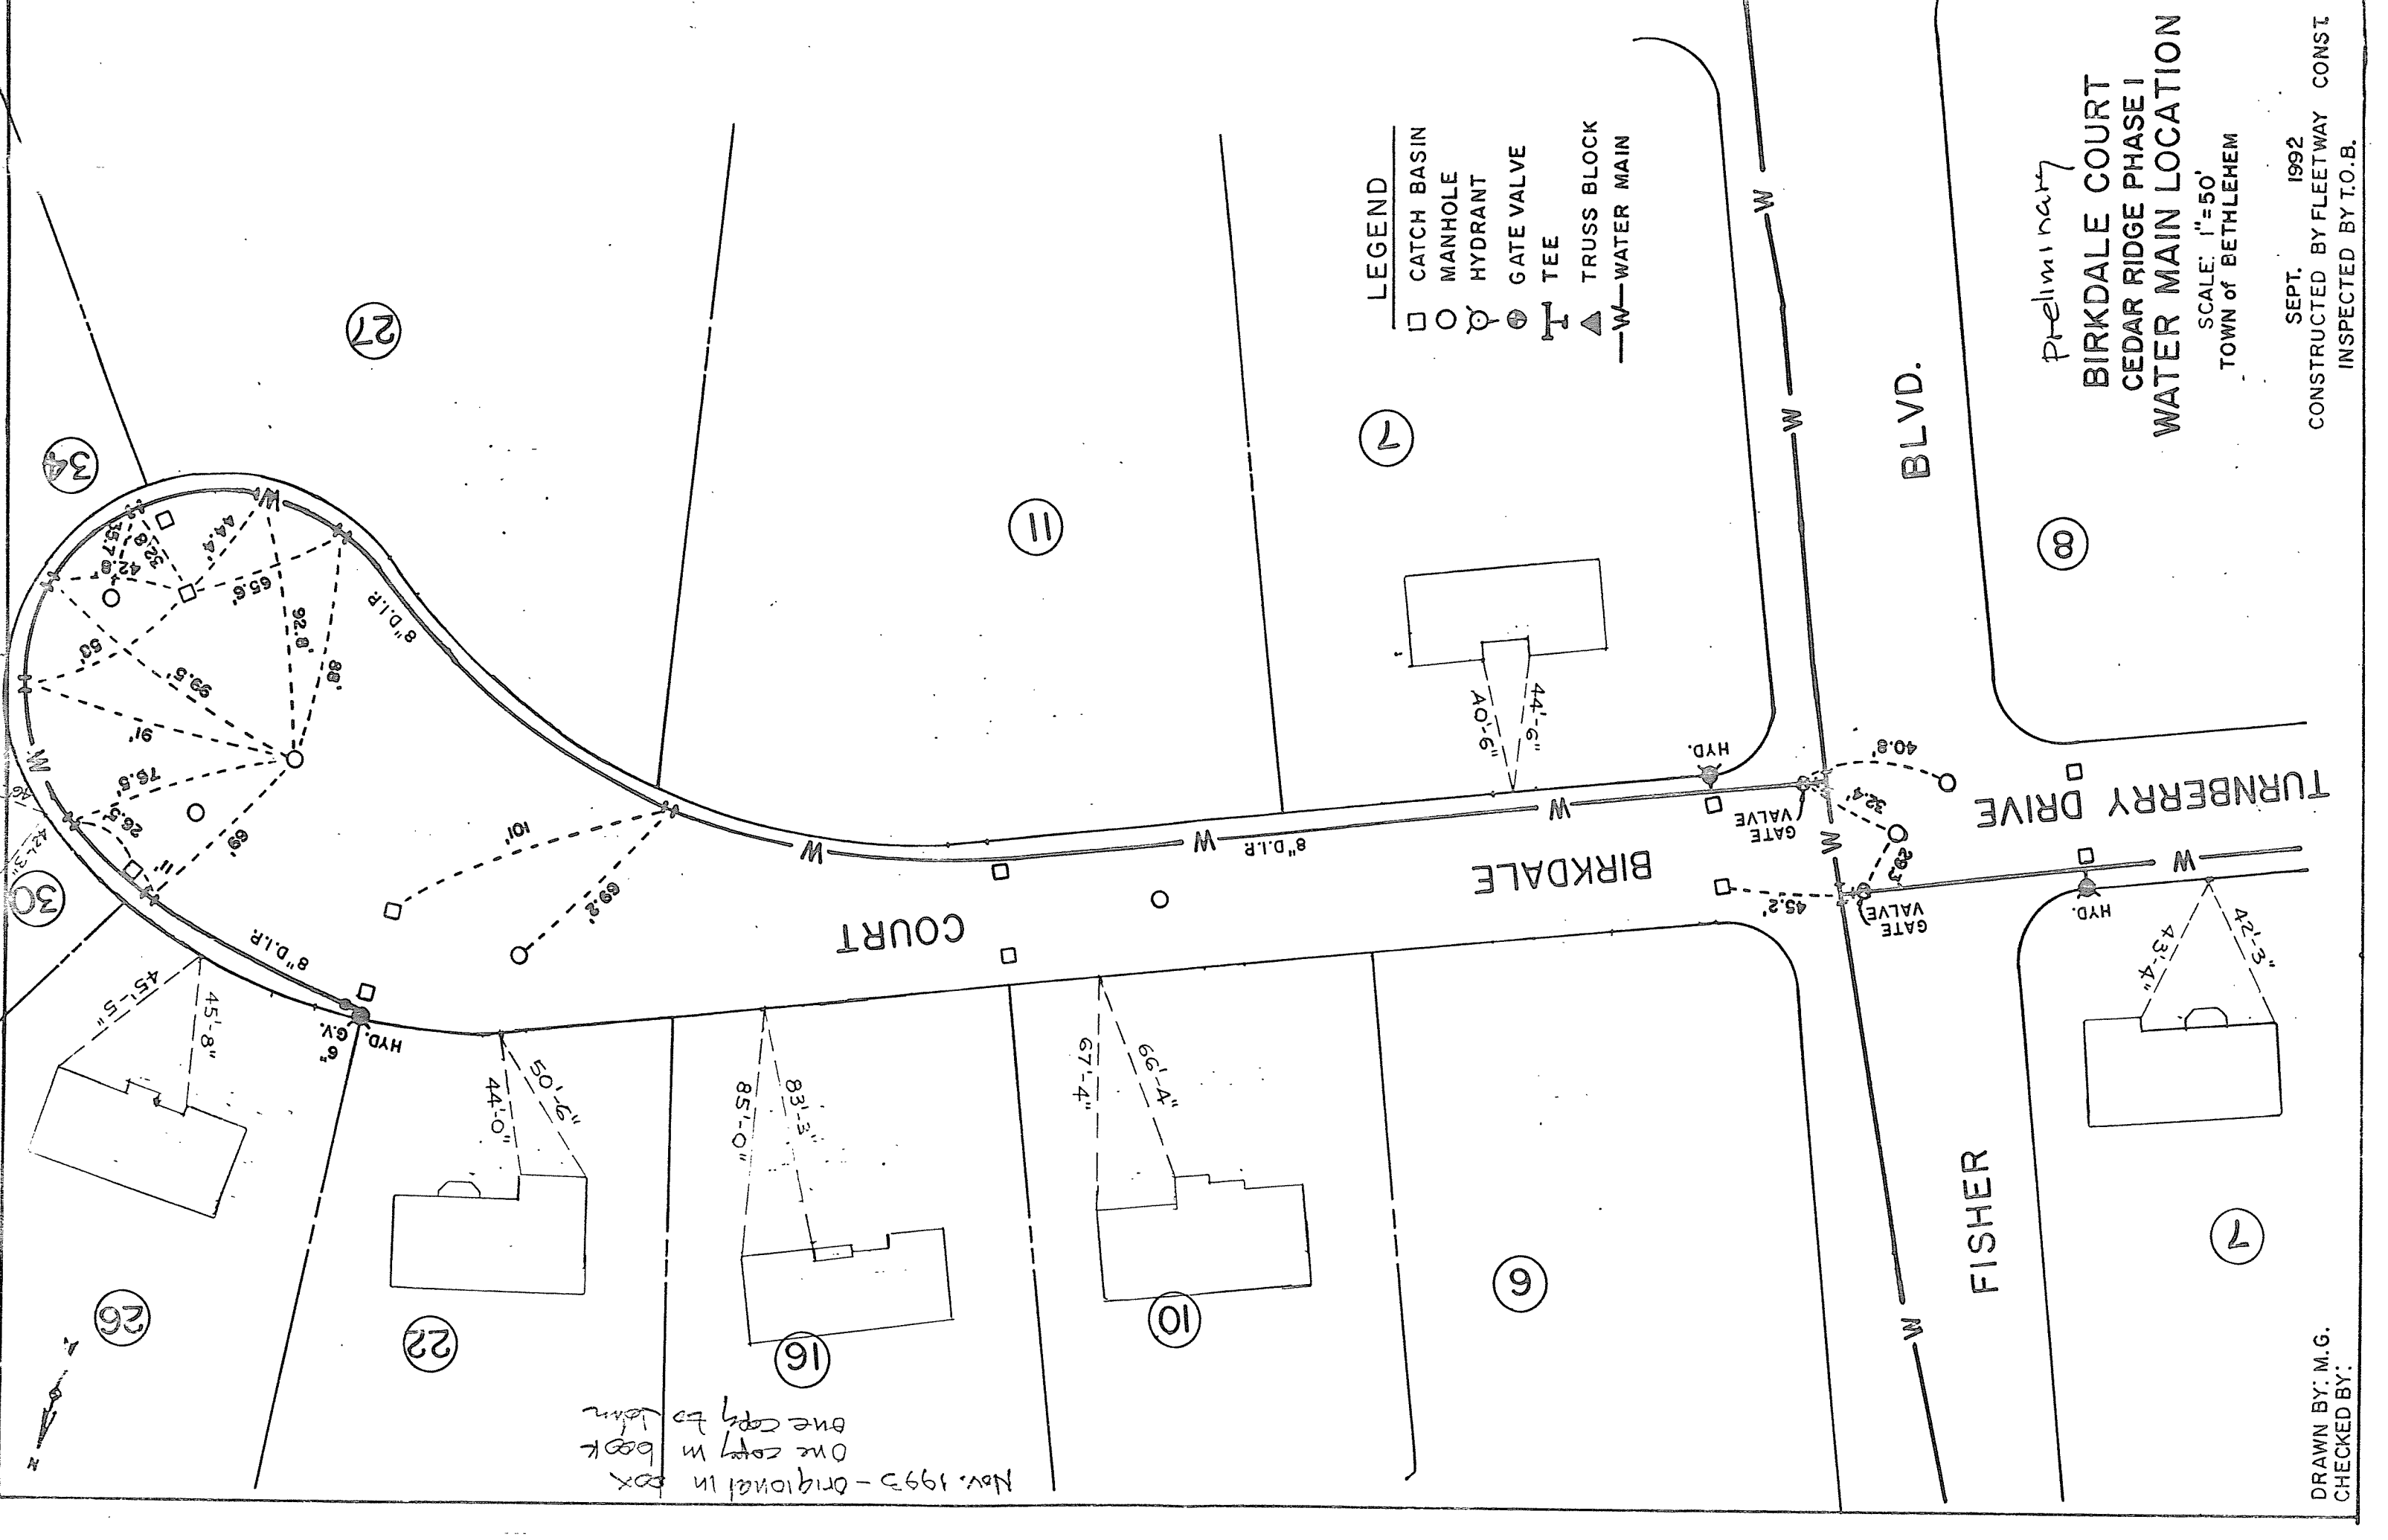

Nov. 1993 - original in box
one copy in book
one copy to town

- LEGEND
- CATCH BASIN
 - MANHOLE
 - HYDRANT
 - GATE VALVE
 - TEE
 - TRUSS BLOCK
 - W-WATER MAIN

preliminary
BIRKDALE COURT
CEDAR RIDGE PHASE I
WATER MAIN LOCATION
SCALE: 1"=50'
TOWN of BETHLEHEM