


BROCKLEY DRIVE

WATER DISTRICT NO 1
TOWN OF BETHLEHEM

RECORD OF INSTALLATION

TOWN OF BETHLEHEM ENGINEERING DEPT
SCALE 1"=100'
OCTOBER, 1984
DWN BY JES

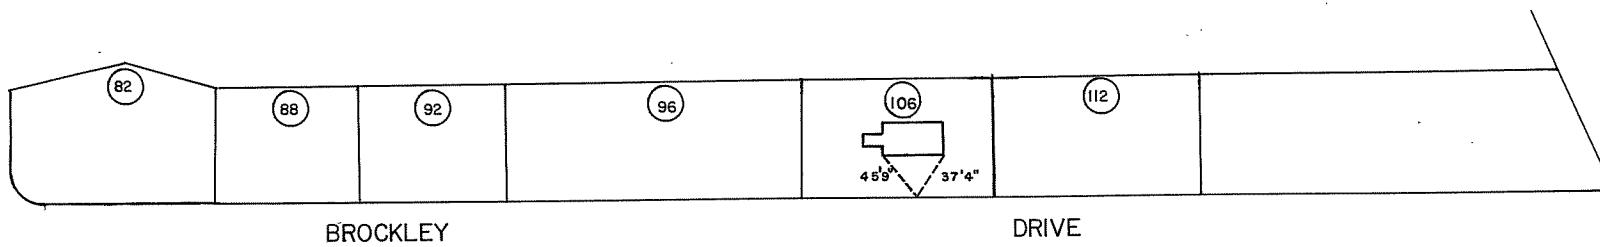

BROCKLEY

DRIVE

