

BROOKMAN AVENUE


WATER DISTRICT NO. 1
TOWN OF BETHLEHEM

RECORD OF INSTALLATION
TOWN OF BETHLEHEM ENGINEERING

DEPARTMENT

SCALE: 1"=50' DECEMBER, 1982

DWN. BY: PDH

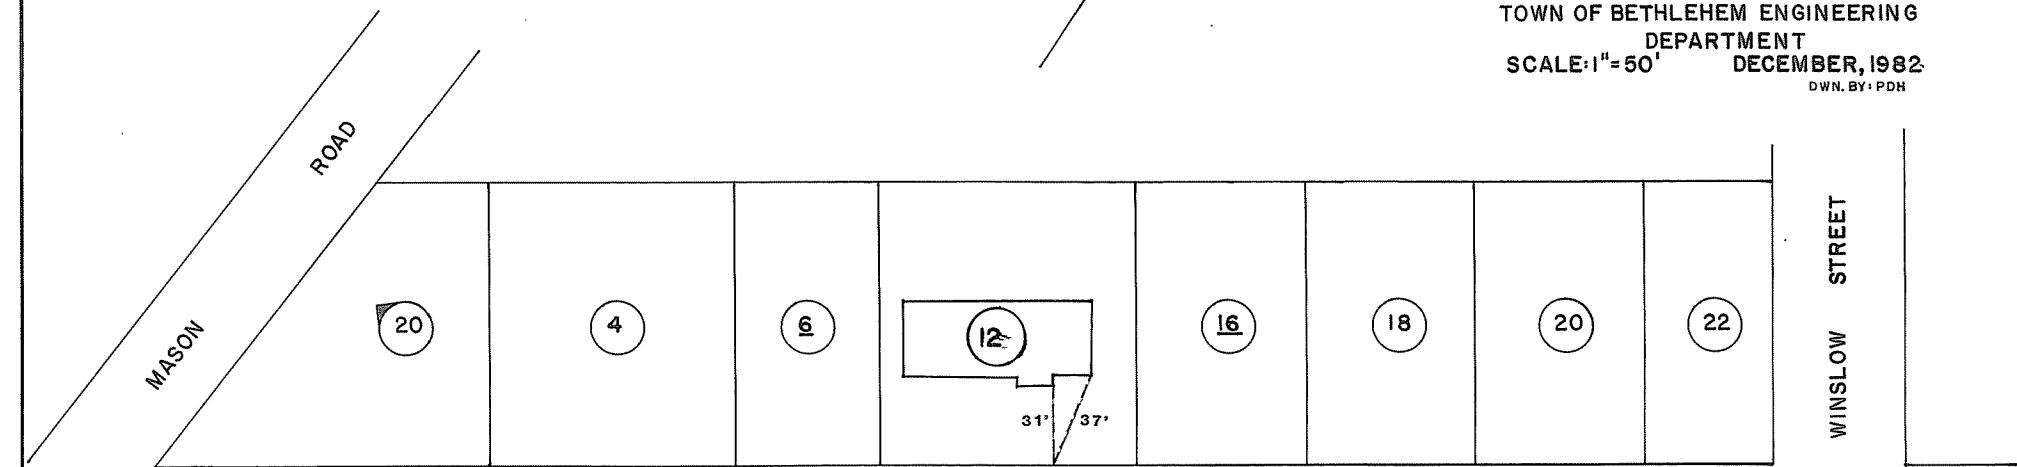

BROOKMAN

AVENUE

