

BROOKMAN AVENUE

WATER DISTRICT NO. 1

TOWN OF BETHLEHEM


RECORD OF INSTALLATION

TOWN OF BETHLEHEM ENGINEERING
DEPARTMENT


SCALE: 1"=50'
DECEMBER, 1982
DWN.BY: PDH




WINSLOW STREET

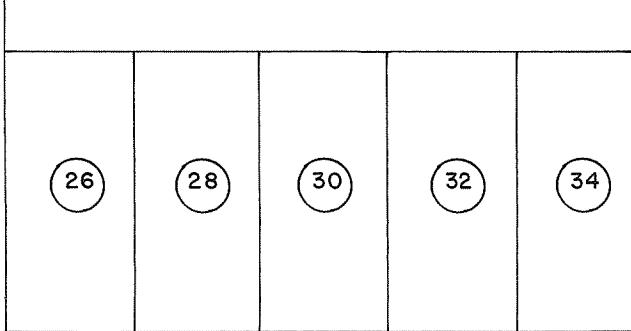

LENNOX STREET

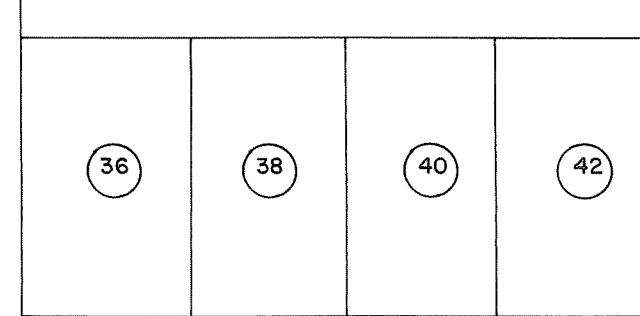

GRANT STREET

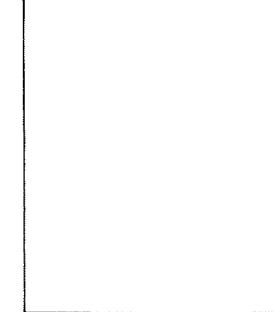

BROOKMAN

AVENUE

