


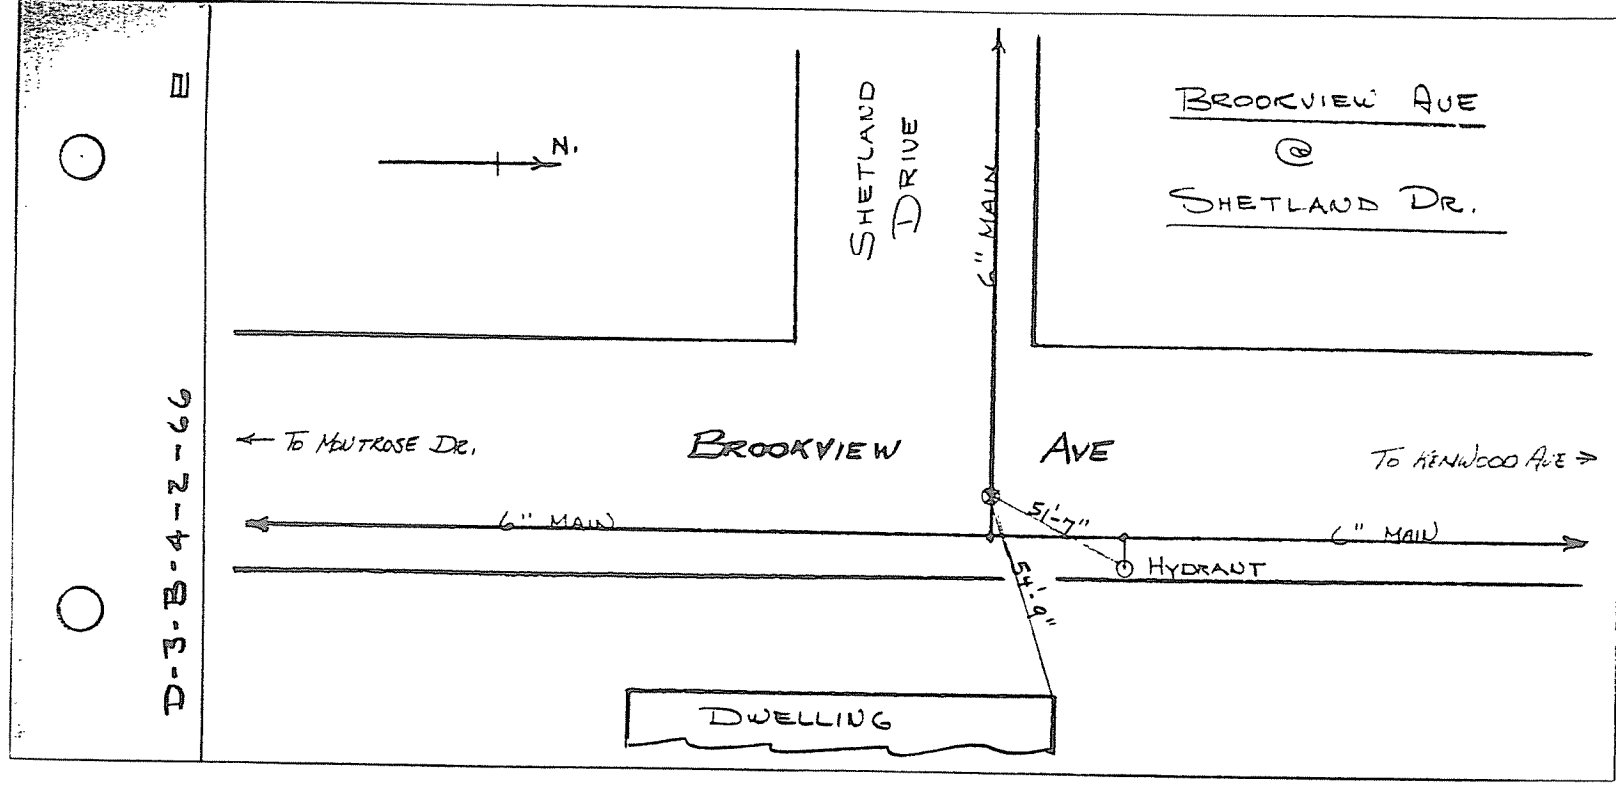

BROOKVIEW AVE
WATER MAIN