

NEW SCOTLAND RD.
 6" C.I.P.
 12" C.I.P.
 52'-2"

M.H.
 N.M. POLE
 173

8x6 REDUCER

CALDWELL BLVD.
 8" D.I.P.

could not locate


could not locate
 39.3'
 12.7'
 1.9'
 35.6'

8" D.I.P.

DANIEL STREET

LEGEND

- CATCH BASIN
- MANHOLE
- HYDRANT
- GATE VALVE
- TEE
- THRUST BLOCK
- WATER MAIN

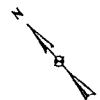

CALDWELL BLVD.
 & DANIEL STREET

INSTALLED BY THE T.O.B.

SCALE: N.T.S.
 DWN. 03/7/90