


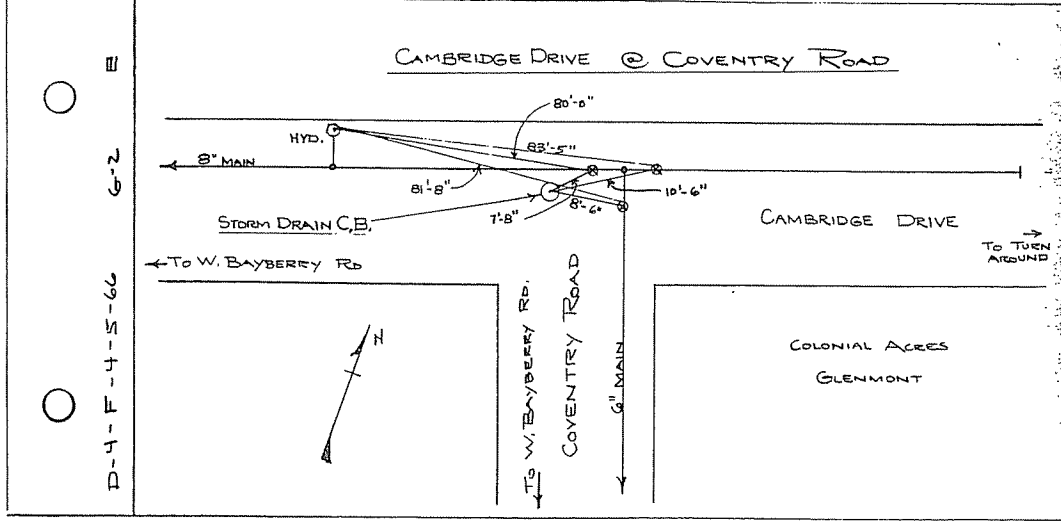

CAMBRIDGE DRIVE

WATER MAIN