


CAROLANNE DRIVE

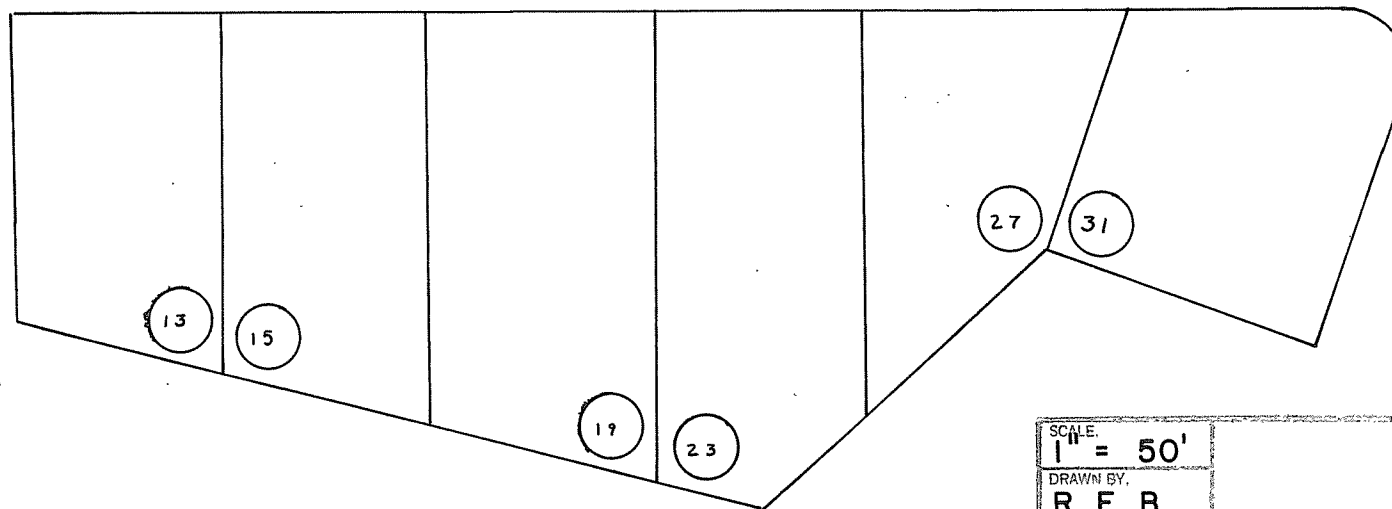

SCALE. 1" = 50'		DRAWING NUMBER.
DRAWN BY. R E B		
APPROVED.		
DATE.		
		TOWN OF BETHLEHEM ENGINEERING DEPARTMENT 495 DELAWARE AVE. BELMAR, NEW YORK 12004