

CAROLANNE DRIVE

WATER DISTRICT NO. 1

TOWN OF BETHLEHEM


RECORD OF INSTALLATION

TOWN OF BETHLEHEM ENGINEERING DEPT.

SCALE: 1" = 50'

JUNE, 1984


DWN. BY: KT

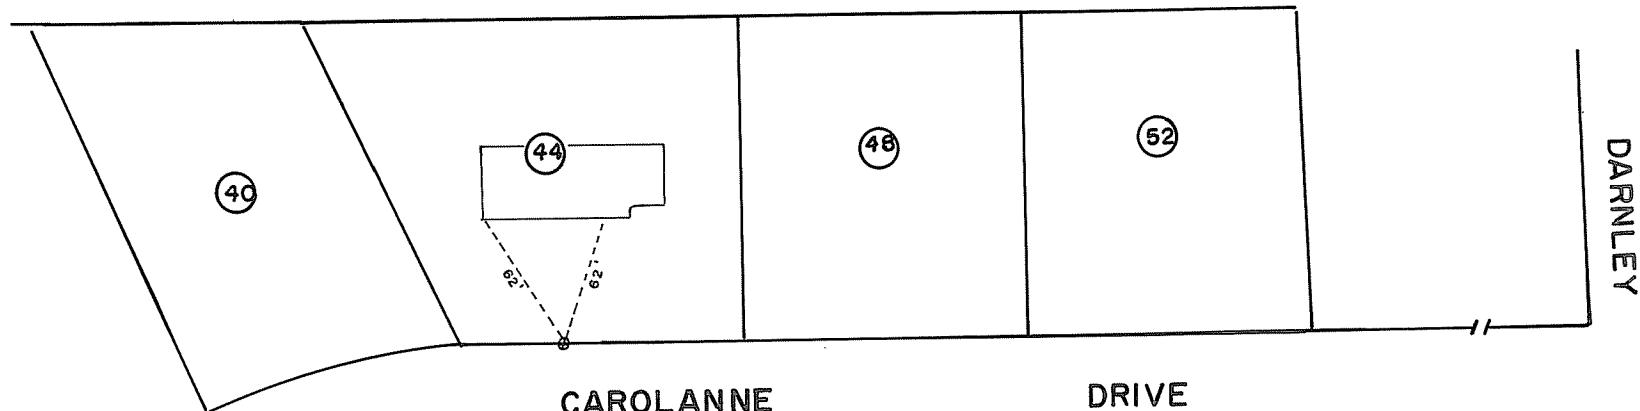

CAROLANNE DRIVE

DARNLEY

GREENE

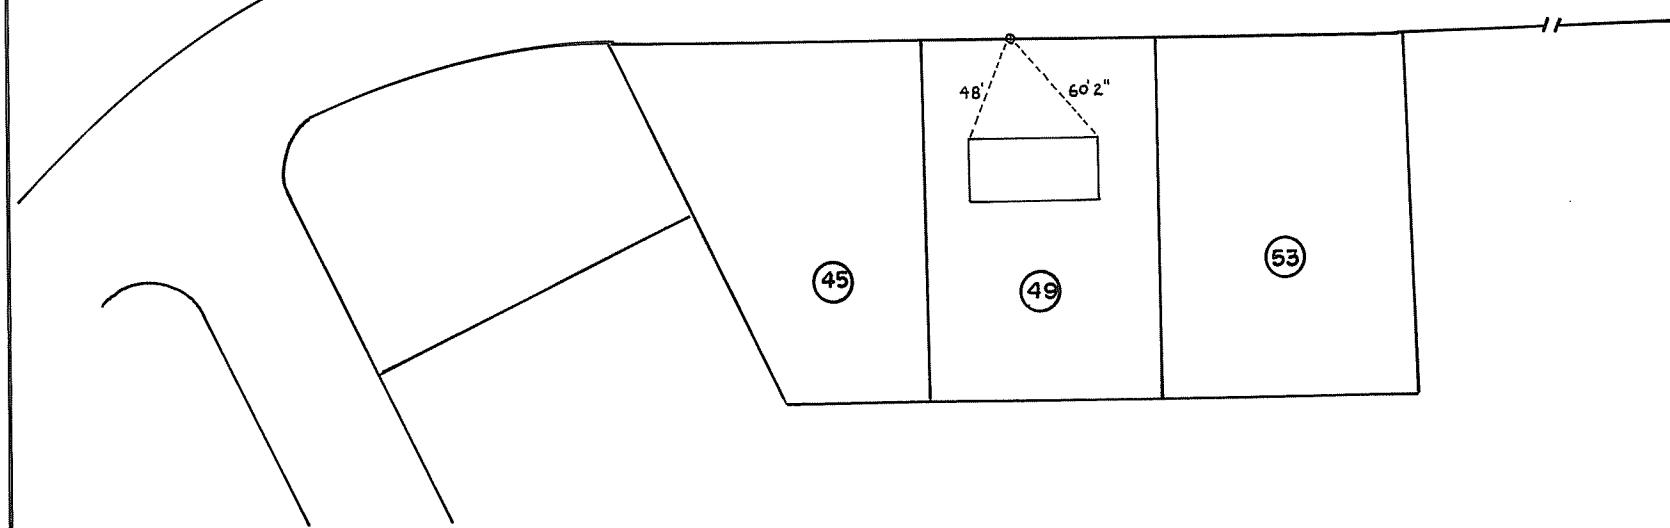

CAROLANNE DRIVE

GREENE