




CARSON ROAD  
"KENAWARE"  
WATER DISTRICT NO. 1  
TOWN OF BETHLEHEM  
**RECORD OF INSTALLATION**  
TOWN OF BETHLEHEM ENGINEERING  
DEPARTMENT  
SCALE: 1"=50' FEBRUARY, 1982  
DWN. BY: PDH

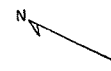

HURON  
ROAD

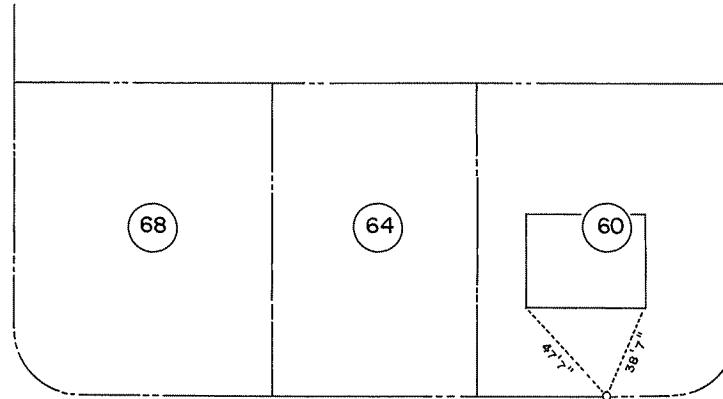


SIBLEY PLACE

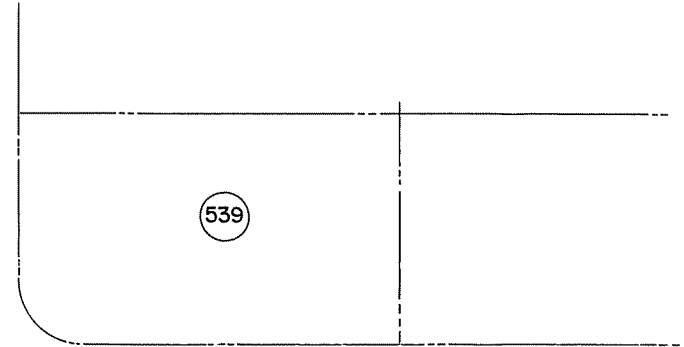

CARSON  
ROAD

KIMBERLY PLACE

HURON  
ROAD

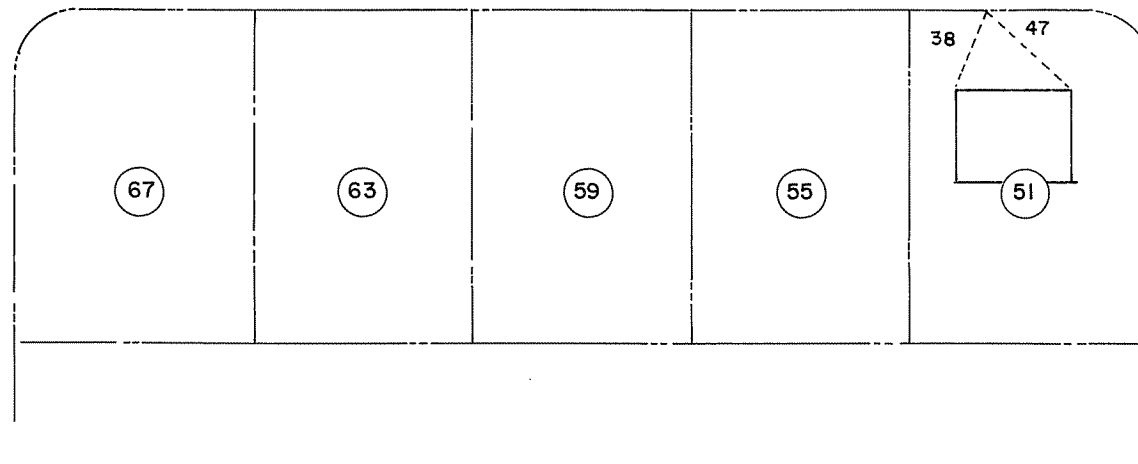

KIMBERLY PLACE

