


RECORD OF INSTALLATIONS

J. KENNETH FRASER & ASSOCIATES, P.C.

CONSULTING ENGRS. RENSSELAER, N.Y.

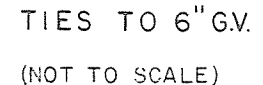

TIES TO 6" G.V.

(NOT TO SCALE)

48

52

56

60

62

66

68

70

74

77

63

71

61

57

(53)

(49)

NOTE:

TYPICAL STORM SEWER MANHOLE

TO WATER LINE

5' $\mathbb{C} - \mathbb{C}$ (HORIZ.)

5' RIM TO TOP OF PIPE

8"X 6" TEE
6" D.G.V. - HYD
8" PLUG (M.J.)

THRUST BLOCK

SCALE 1"=50'

/ OF /

⊗ DENOTES LINE VALVE