


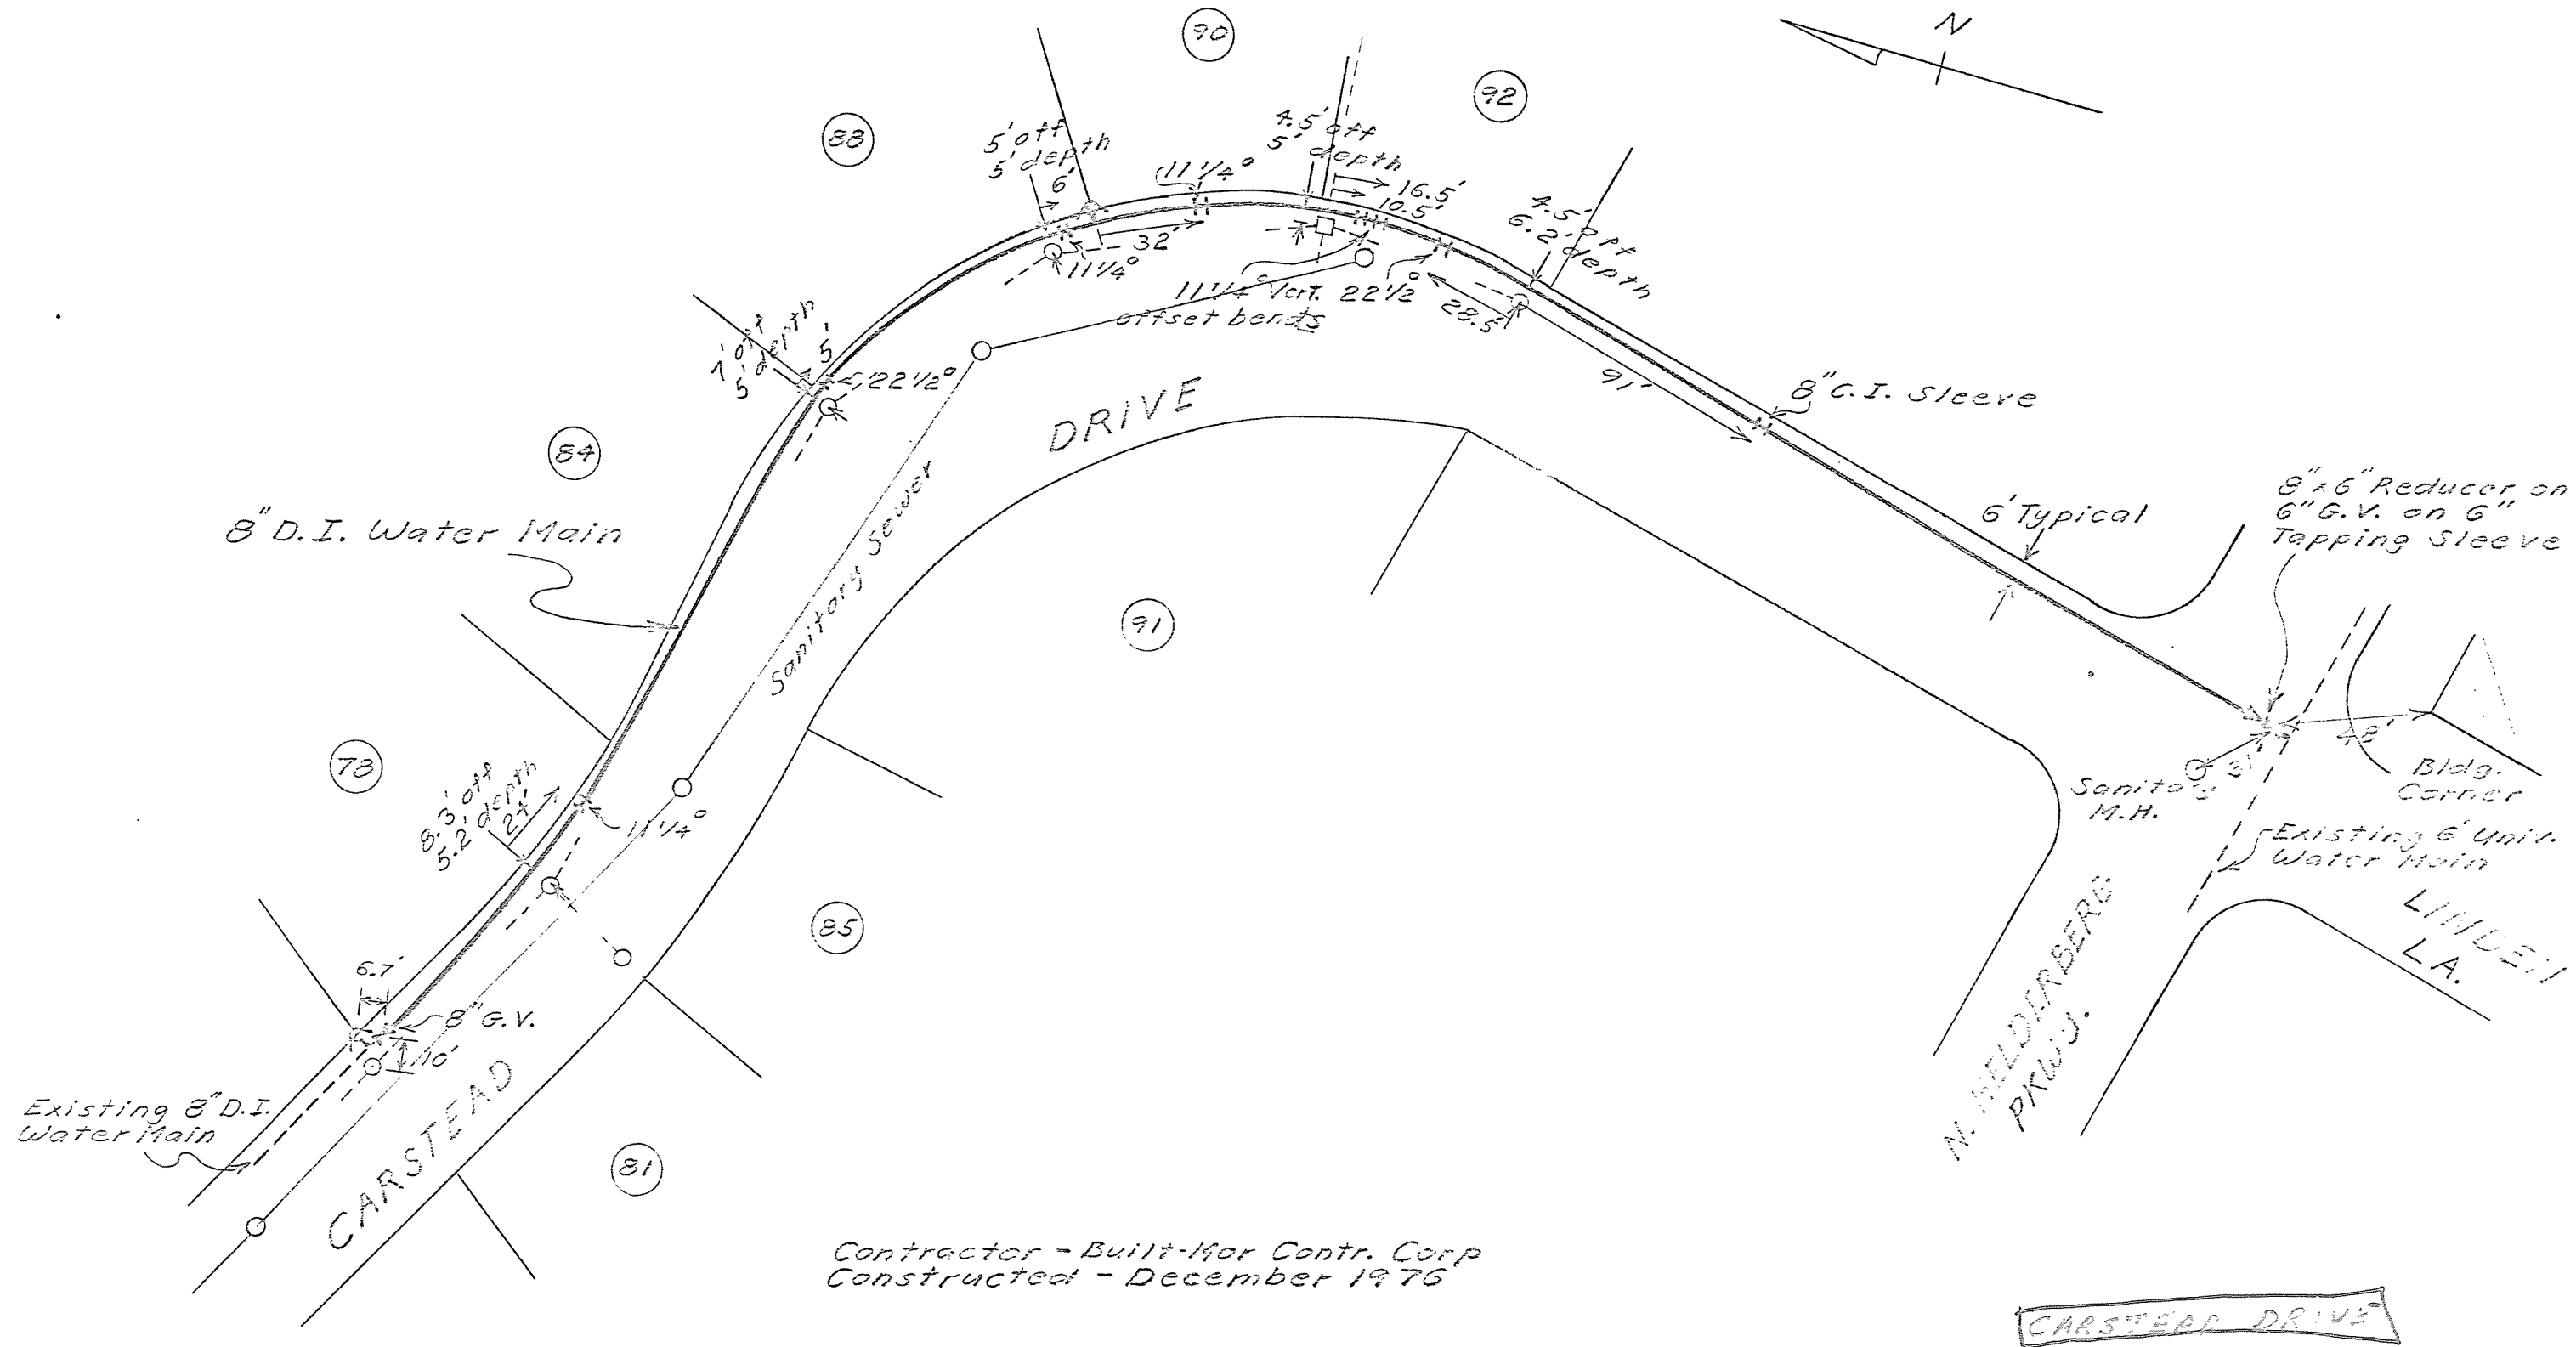

Contractor - Built-Mor Contr. Corp
Constructed - December 1976

- Hydrant, Gate Valve, Bend
- Storm Sewer
- Property Line

CARSTEAD DRIVE

LINDENWOOD
WATER DISTRICT NO. 1
TOWN OF BETHLEHEM
RECORD OF INSTALLATIONS
J. KENNETH FRASER & ASSOCIATES, P.C.
CONSULTING ENGRS. RENSSELAER, N.Y.
SCALE 1" = 50' DECEMBER, 1976

Dwn. by JJB
Chk. by WTB