
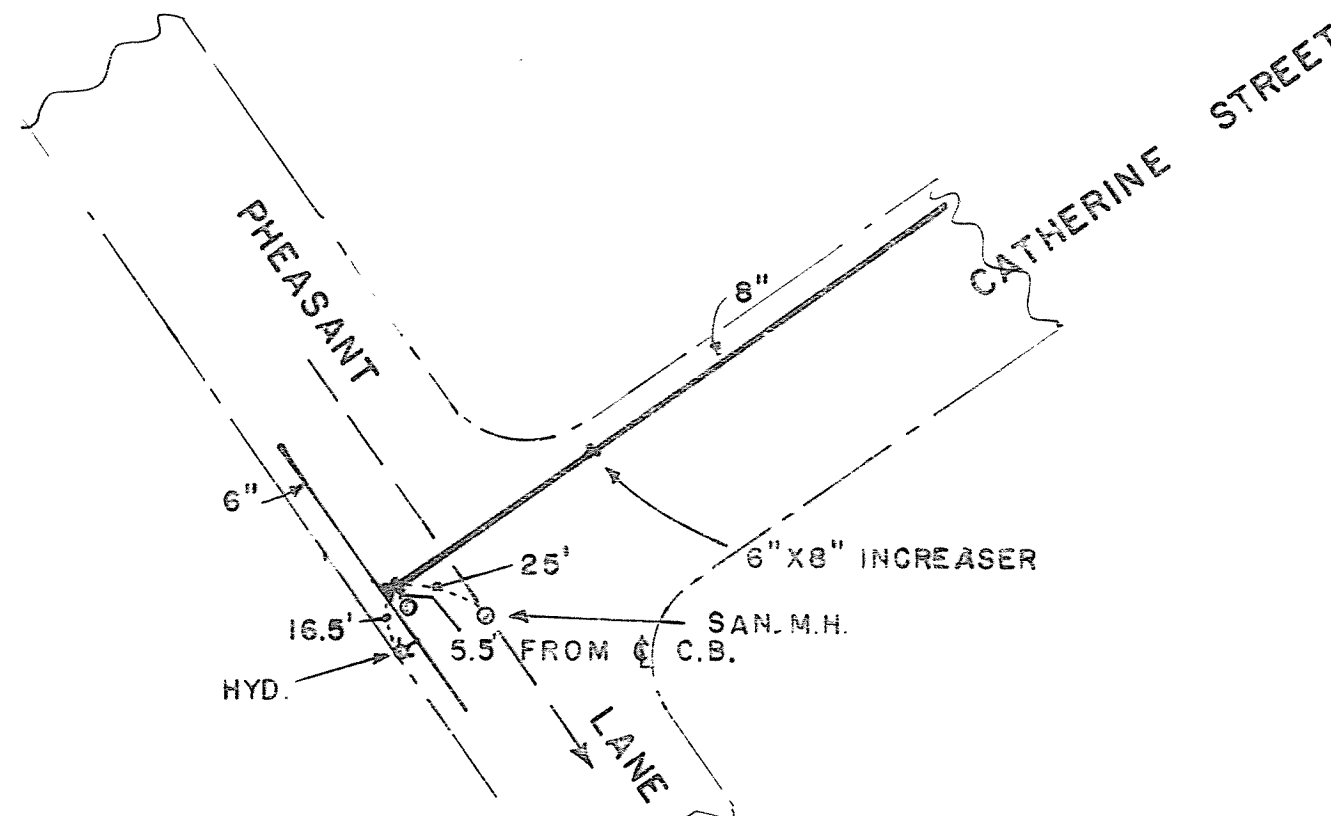
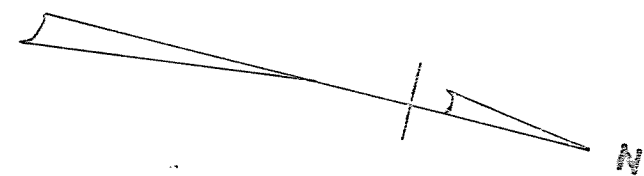


# WATER MAIN LOCATION AT STORM INLETS

MIDDLE LOT # 36	— 7.0'	OFF — 3.3'	COVER BELOW FRAME
LOT LINE 36-30	— 5.0'	" — 4.8'	" " "
" " 24-20	— 4.5'	" — 3.0'	" " "
" " 20-16	— 4.5'	" — 2.0'	" " "
" " 14-10	— 5.5'	" — 3.7'	" " "
" " 10 (EAST)	— 6.0'	" — 3.9'	" " "

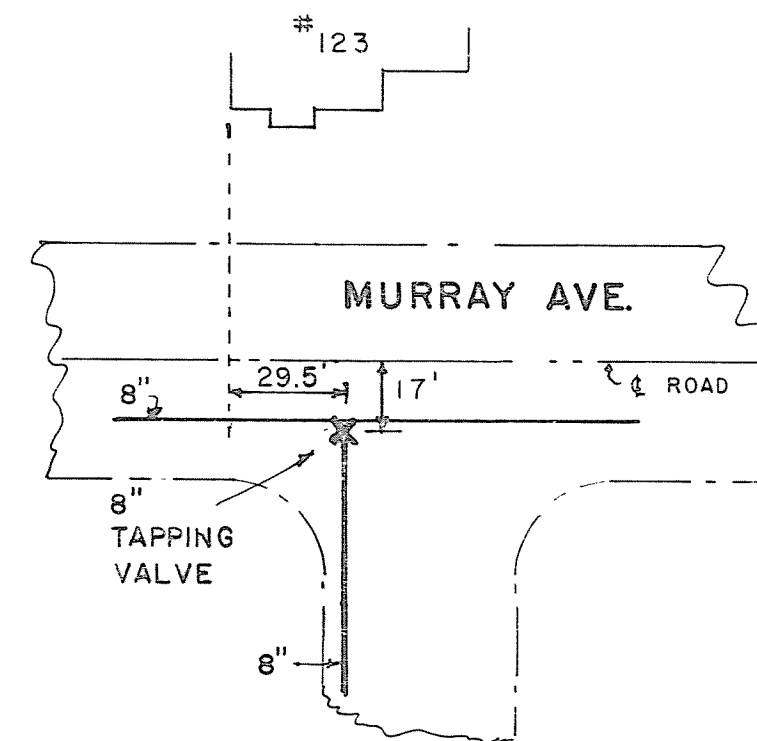

WORK ACCOMPLISHED BY TOWN FORCES  
OCT. 1978

DWN. BY: E.W.O.  
CKD. BY: W.T.B.

CATHERINE STREET  
WATER DISTRICT No. 1  
TOWN OF BETHLEHEM  
RECORD OF INSTALLATION  
SCALE: 1" = 50' OCT. 1978  
J. KENNETH FRASER & ASSOCIATES, P.C.  
CONSULTING ENGINEERS RENSSELAER, N.Y.