


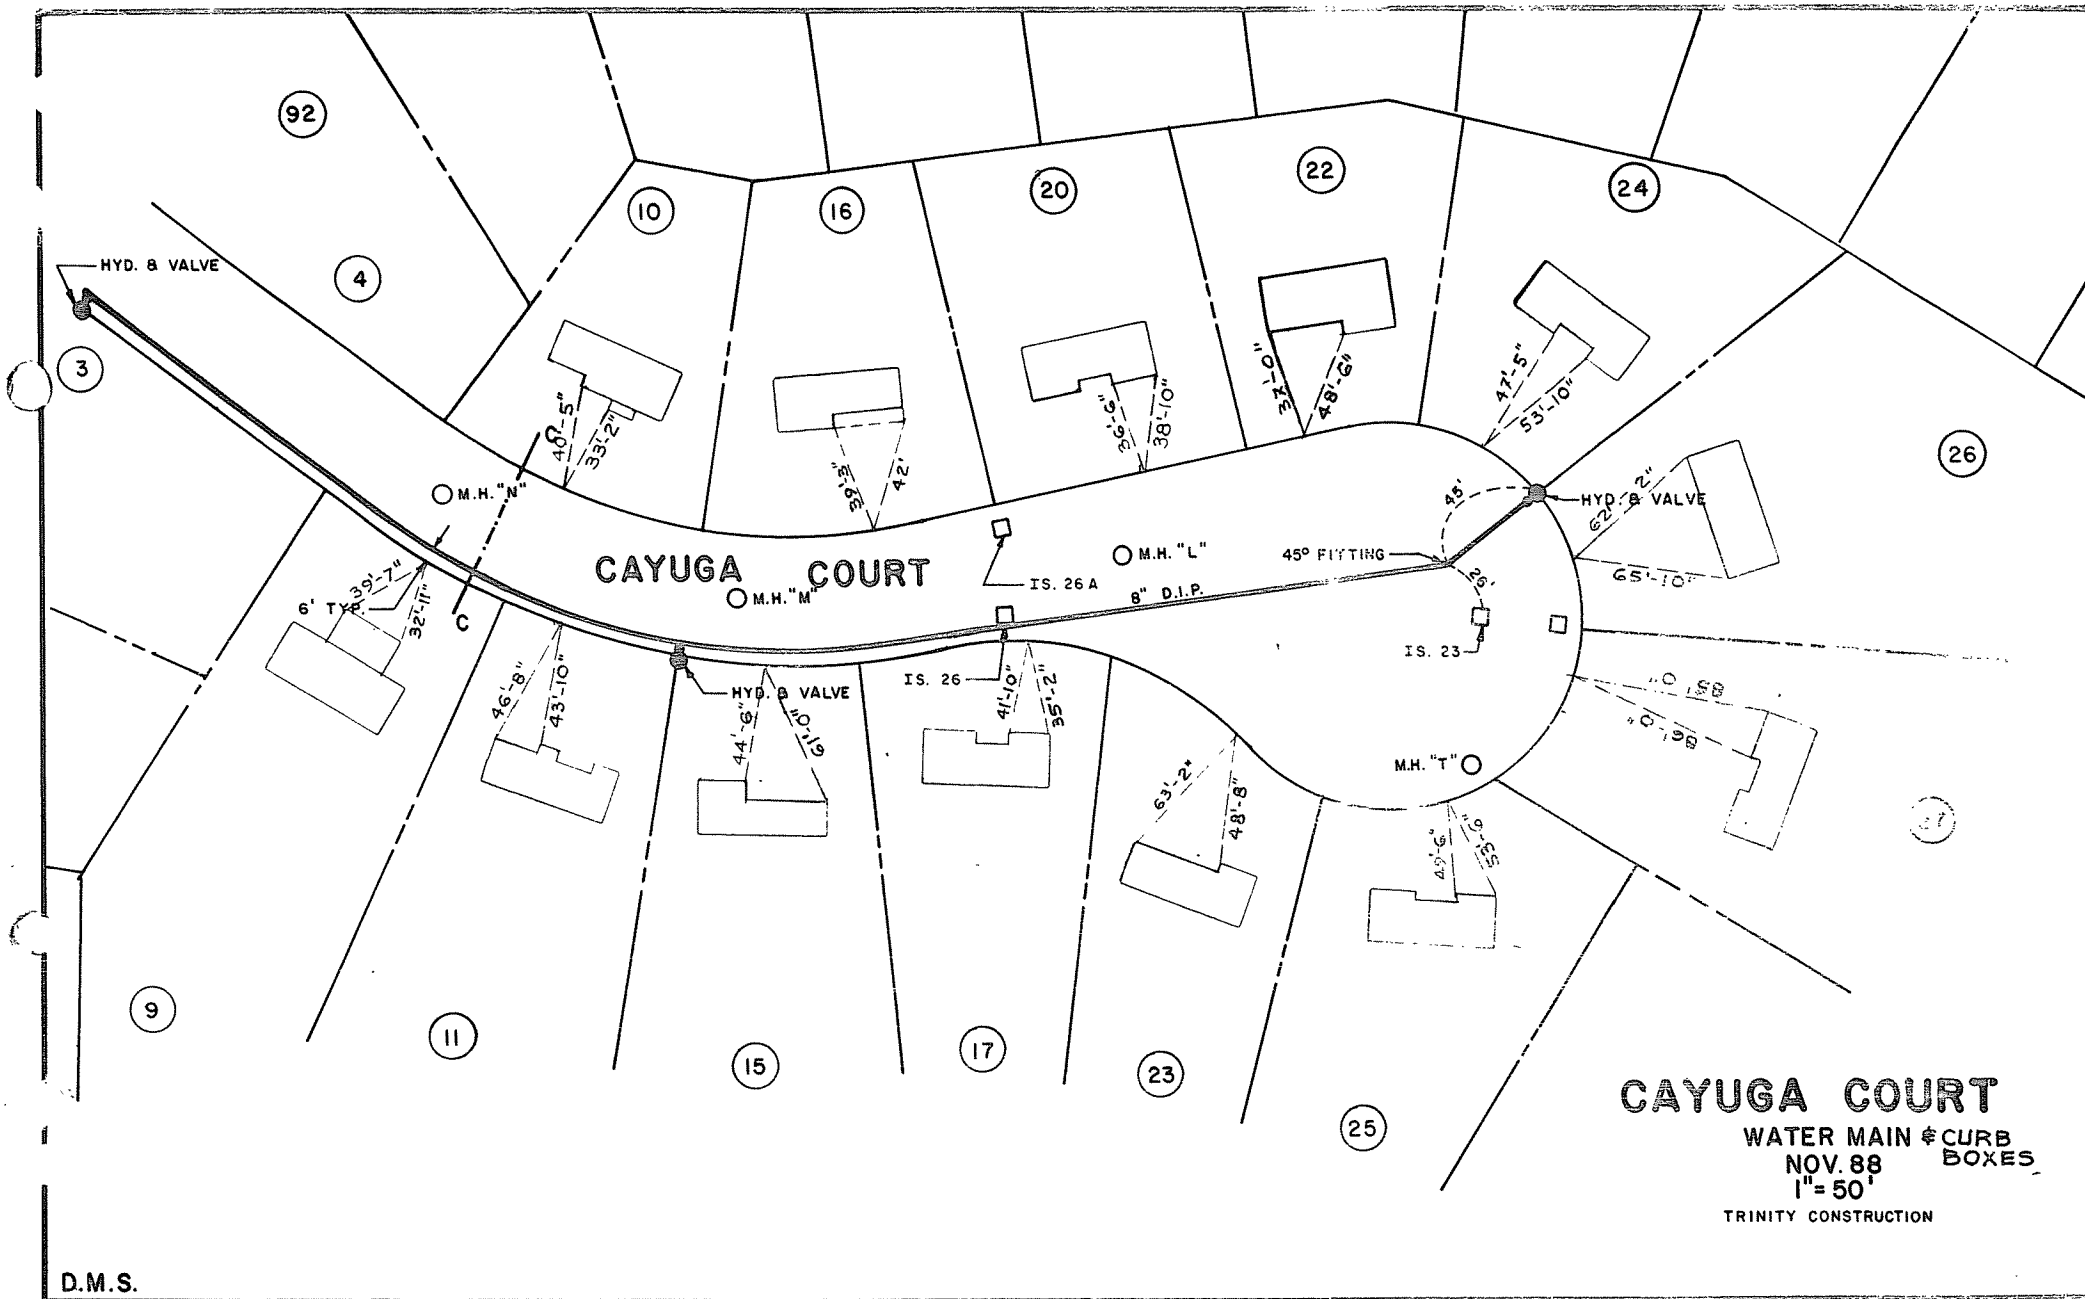

CAYUGA COURT
WATER MAIN & CURB
NOV. 88 BOXES
1" = 50'
TRINITY CONSTRUCTION