


CHERRY AVENUE  
WATER DISTRICT NO.1  
TOWN OF BETHLEHEM

RECORD OF INSTALLATION  
TOWN OF BETHLEHEM ENGINEERING  
DEPARTMENT

SCALE: 1" = 50'      JANUARY, 1982  
DWN.BY: PDH

N 

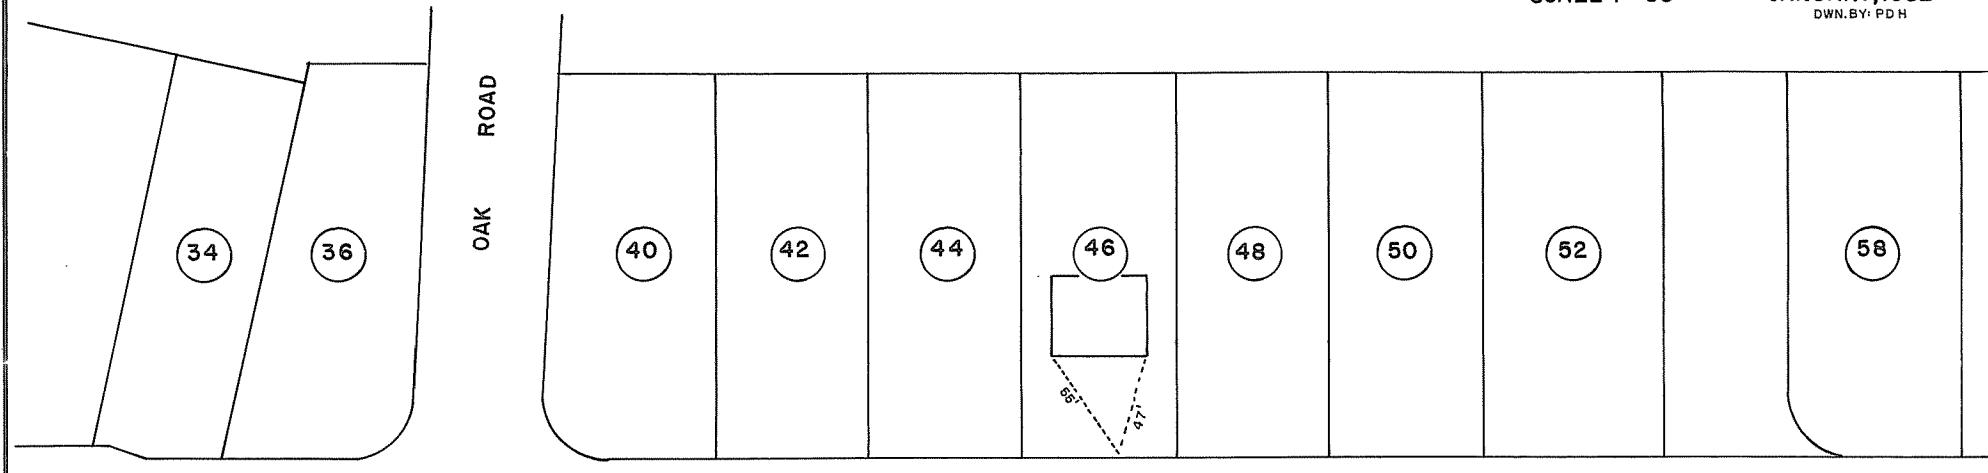

CHERRY

AVENUE

