

CHERRY AVENUE

WATER DISTRICT NO.1

TOWN OF BETHLEHEM

RECORD OF INSTALLATION


TOWN OF BETHLEHEM ENGINEERING

DEPARTMENT

SCALE: 1"=50' JANUARY, 1983

DWN. BY: PDH

N

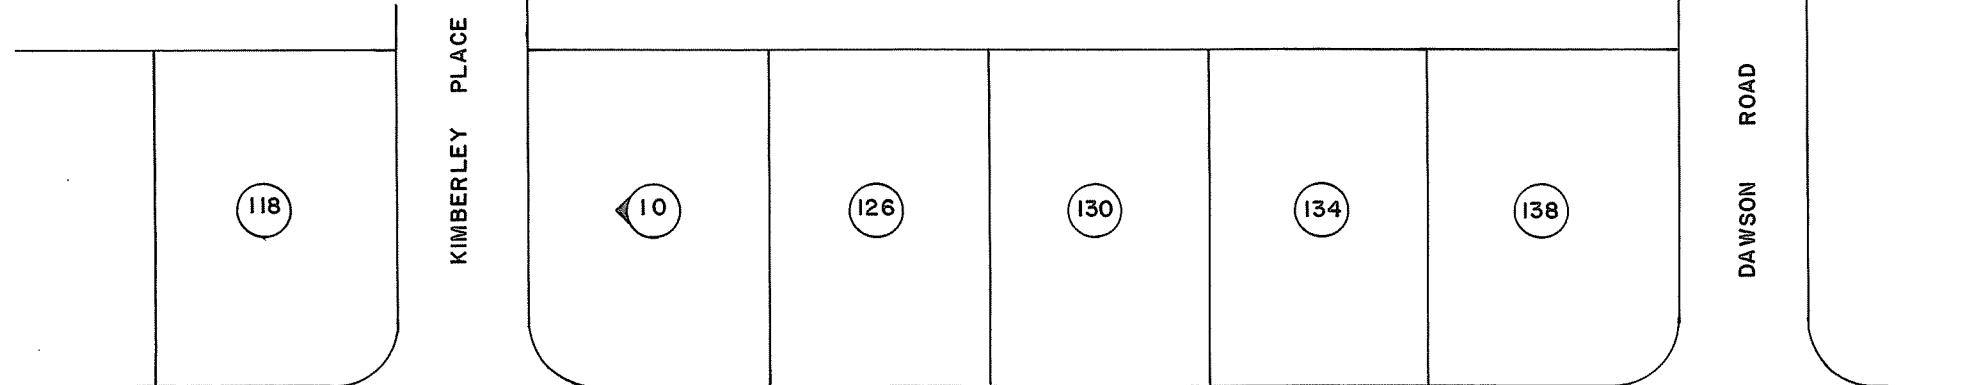

CHERRY

AVENUE

