
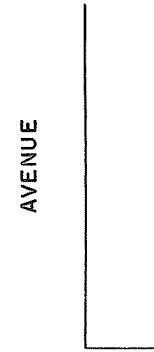
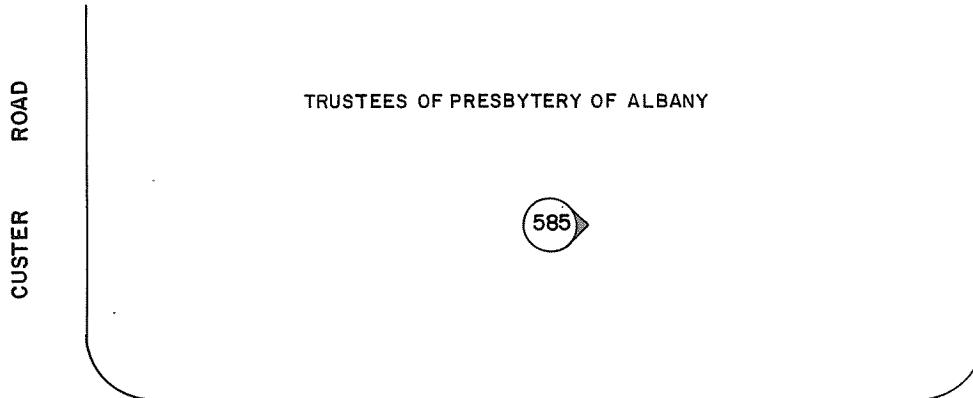


CHERRY AVENUE
WATER DISTRICT NO. 1
TOWN OF BETHLEHEM

RECORD OF INSTALLATION
TOWN OF BETHLEHEM ENGINEERING
DEPARTMENT

SCALE: 1" = 50' JANUARY, 1983
DWN. BY: PDH

N
↗

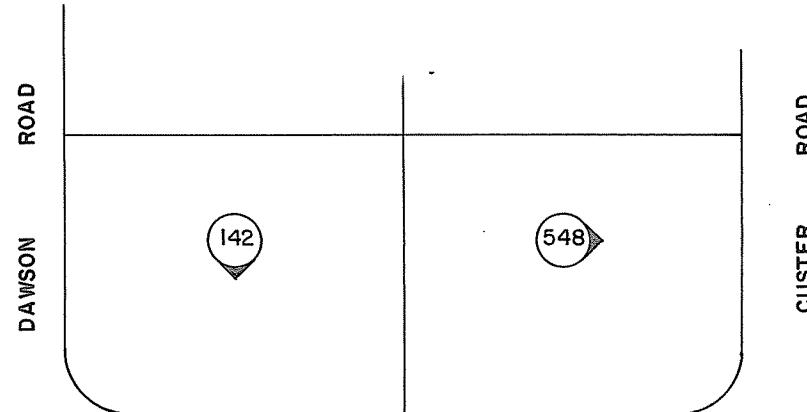

CHERRY

AVENUE

