


CHESTNUT ROAD
LEAF ROAD
WILLOW DRIVE

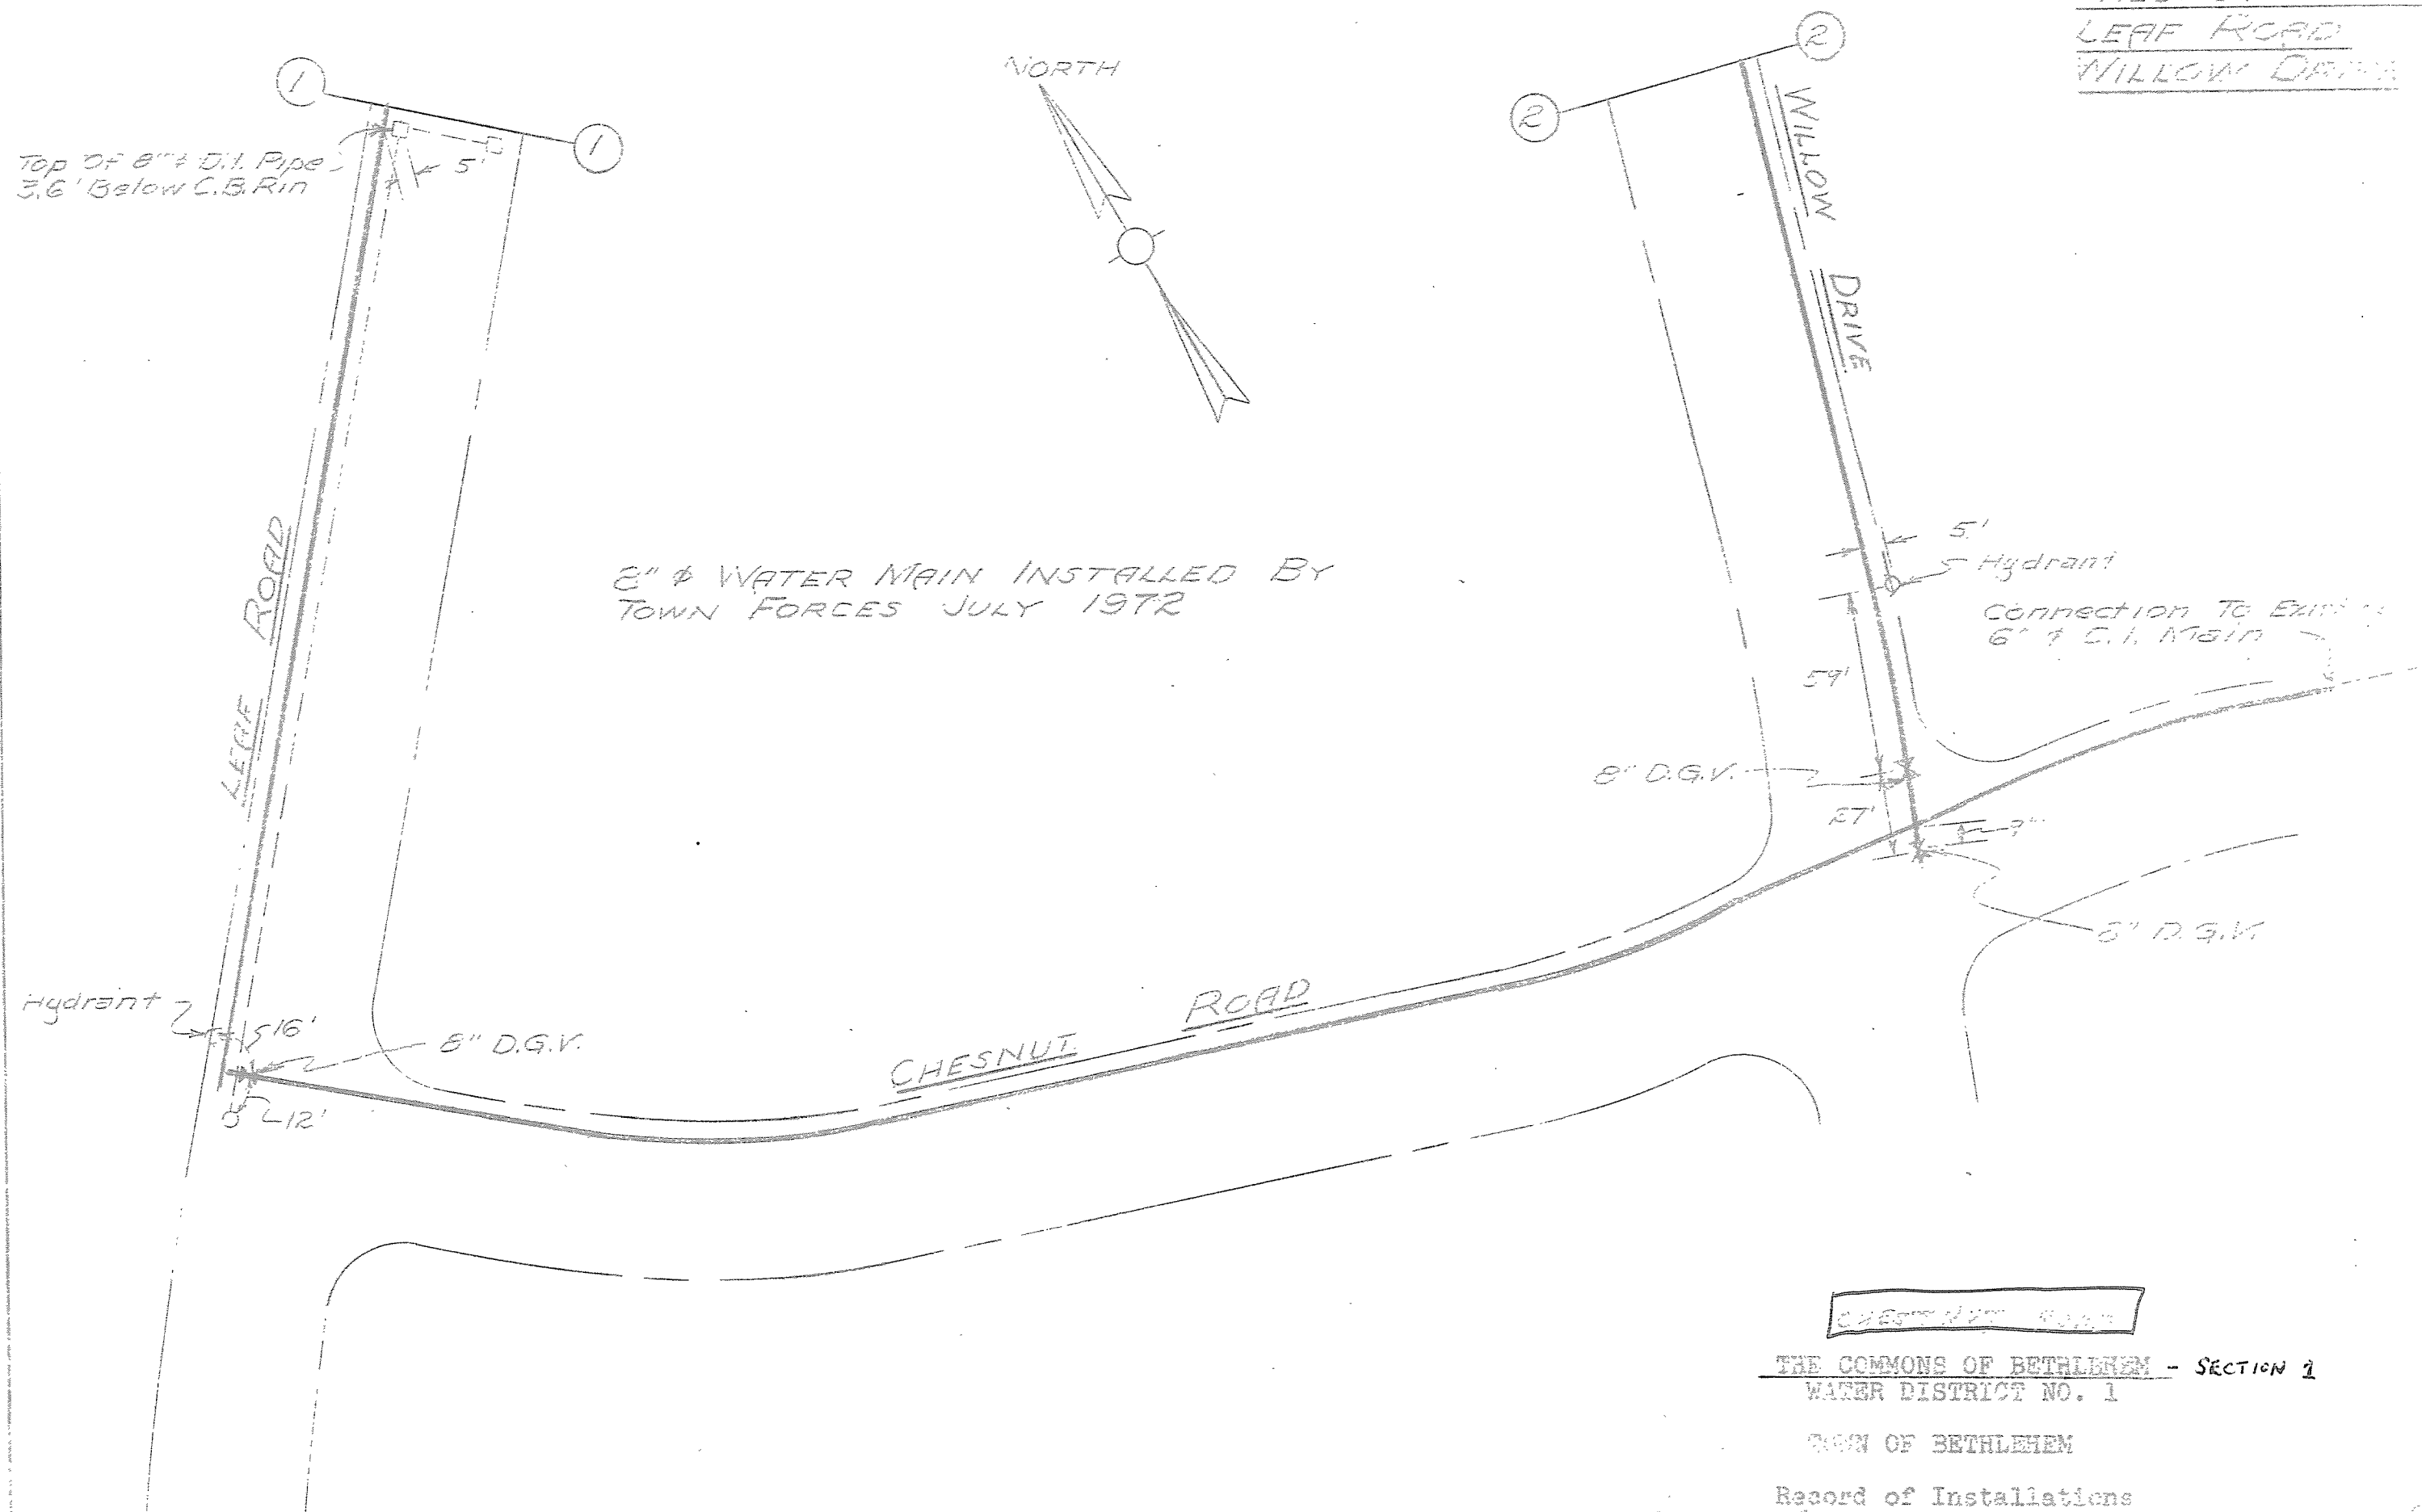

CHESTNUT ROAD

THE COMMONS OF BETHLEHEM - SECTION 1
WATER DISTRICT NO. 1

TOWN OF BETHLEHEM

Record of Installations
Scale 1"=50' July 1972
J. Kenneth Fraser and Associates, P.C.
Consulting Engineers Rensselaer, N.Y.