


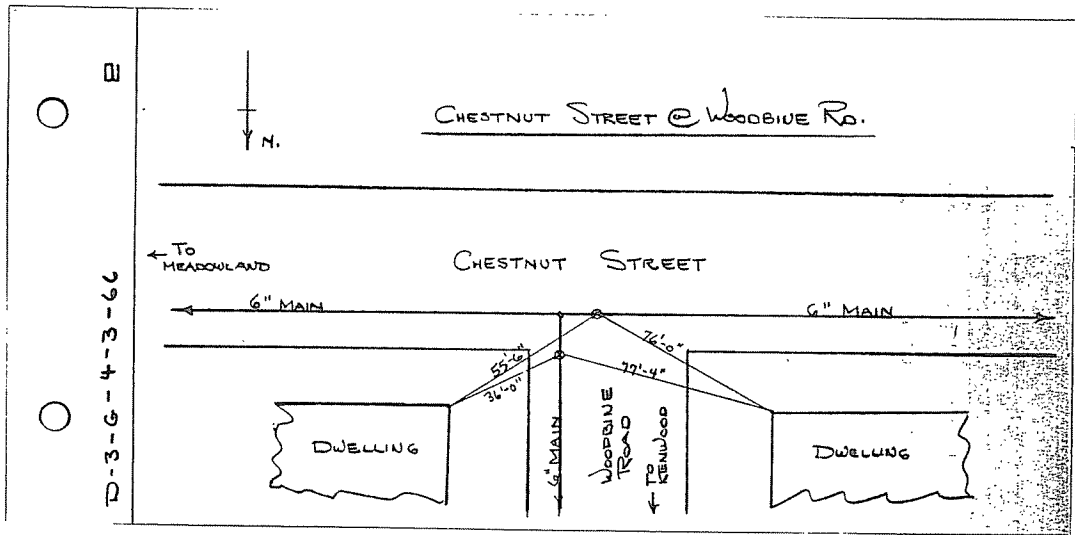

CHESTNUT STREET

WATER MAIN