


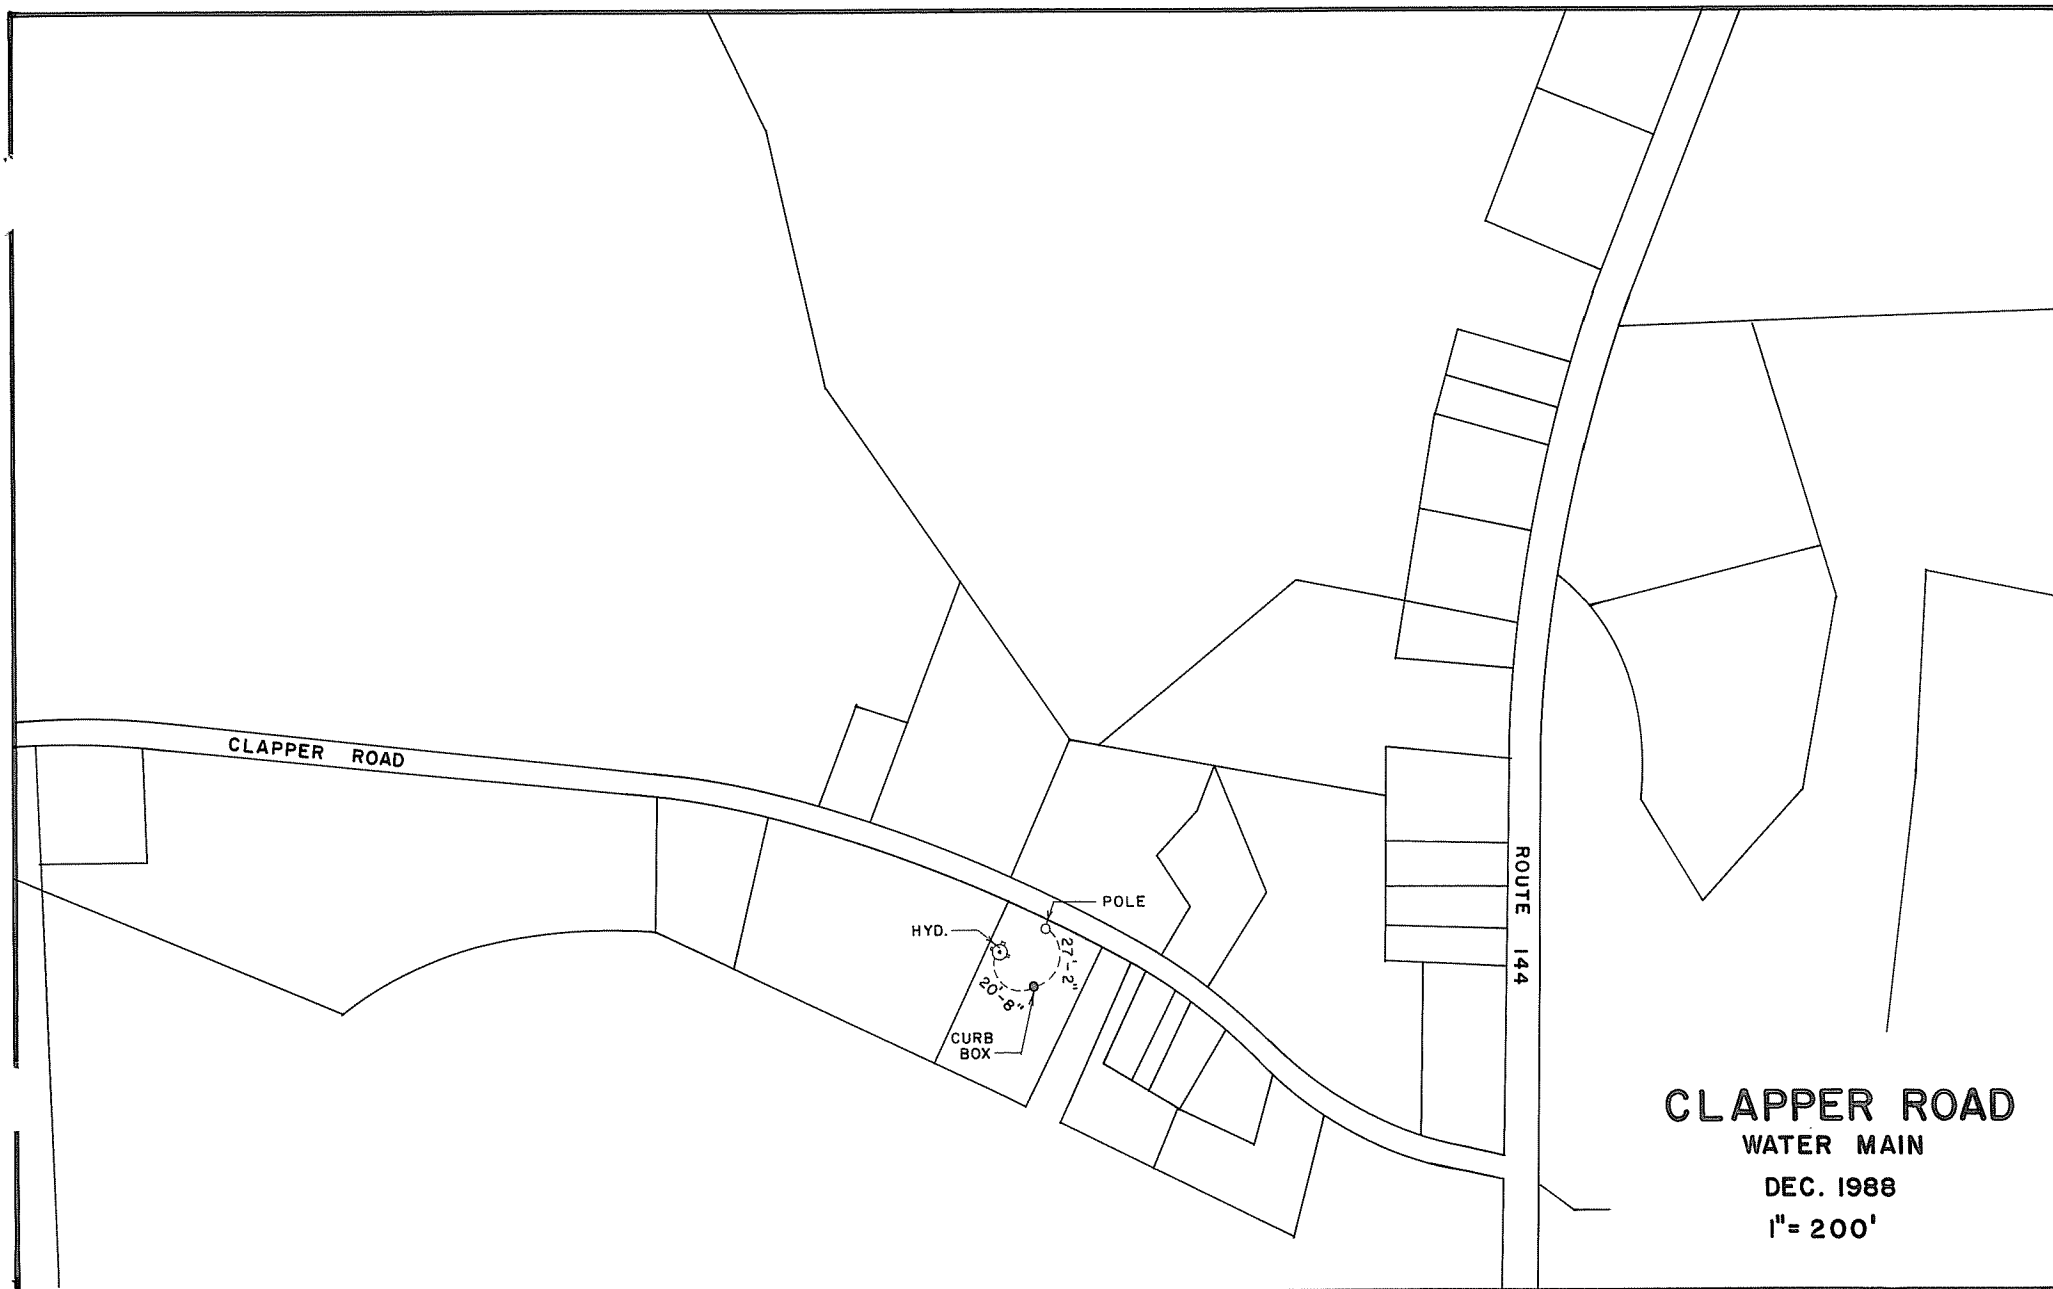

CLAPPER ROAD

WATER MAIN

DEC. 1988

1" = 200'