


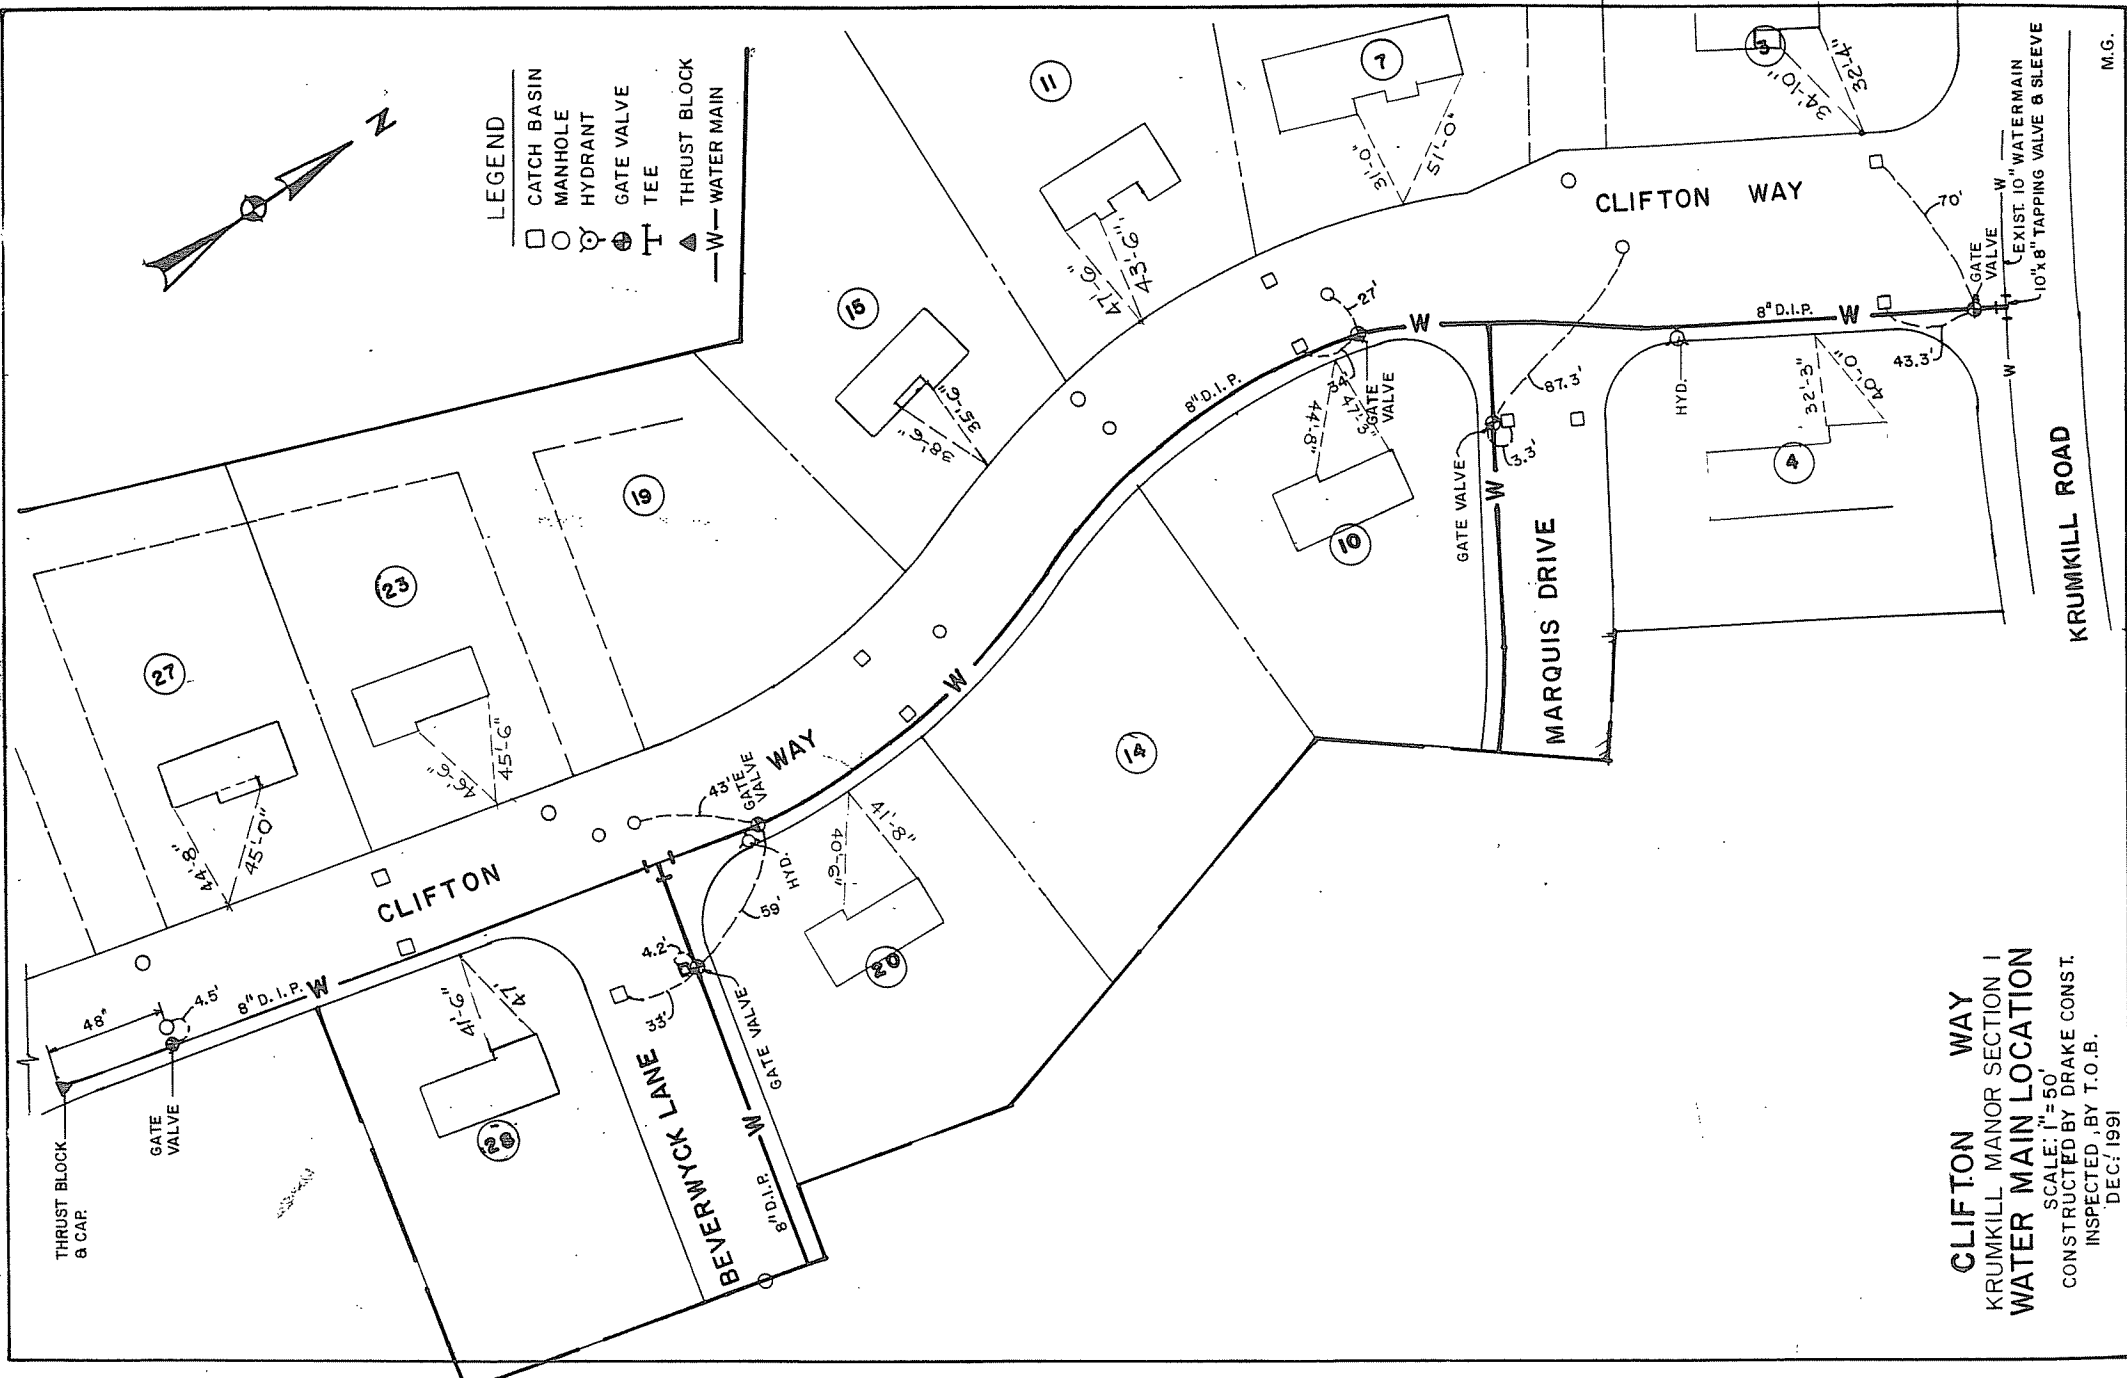

- LEGEND
- CATCH BASIN
 - MANHOLE
 - HYDRANT
 - GATE VALVE
 - TEE
 - THRUST BLOCK
 - W— WATER MAIN

CLIFTON WAY
KRUMKILL MANOR SECTION I
WATER MAIN LOCATION
SCALE: 1"=50'
CONSTRUCTED BY DRAKE CONST.
INSPECTED BY T.O.B.
DEC. 1991