


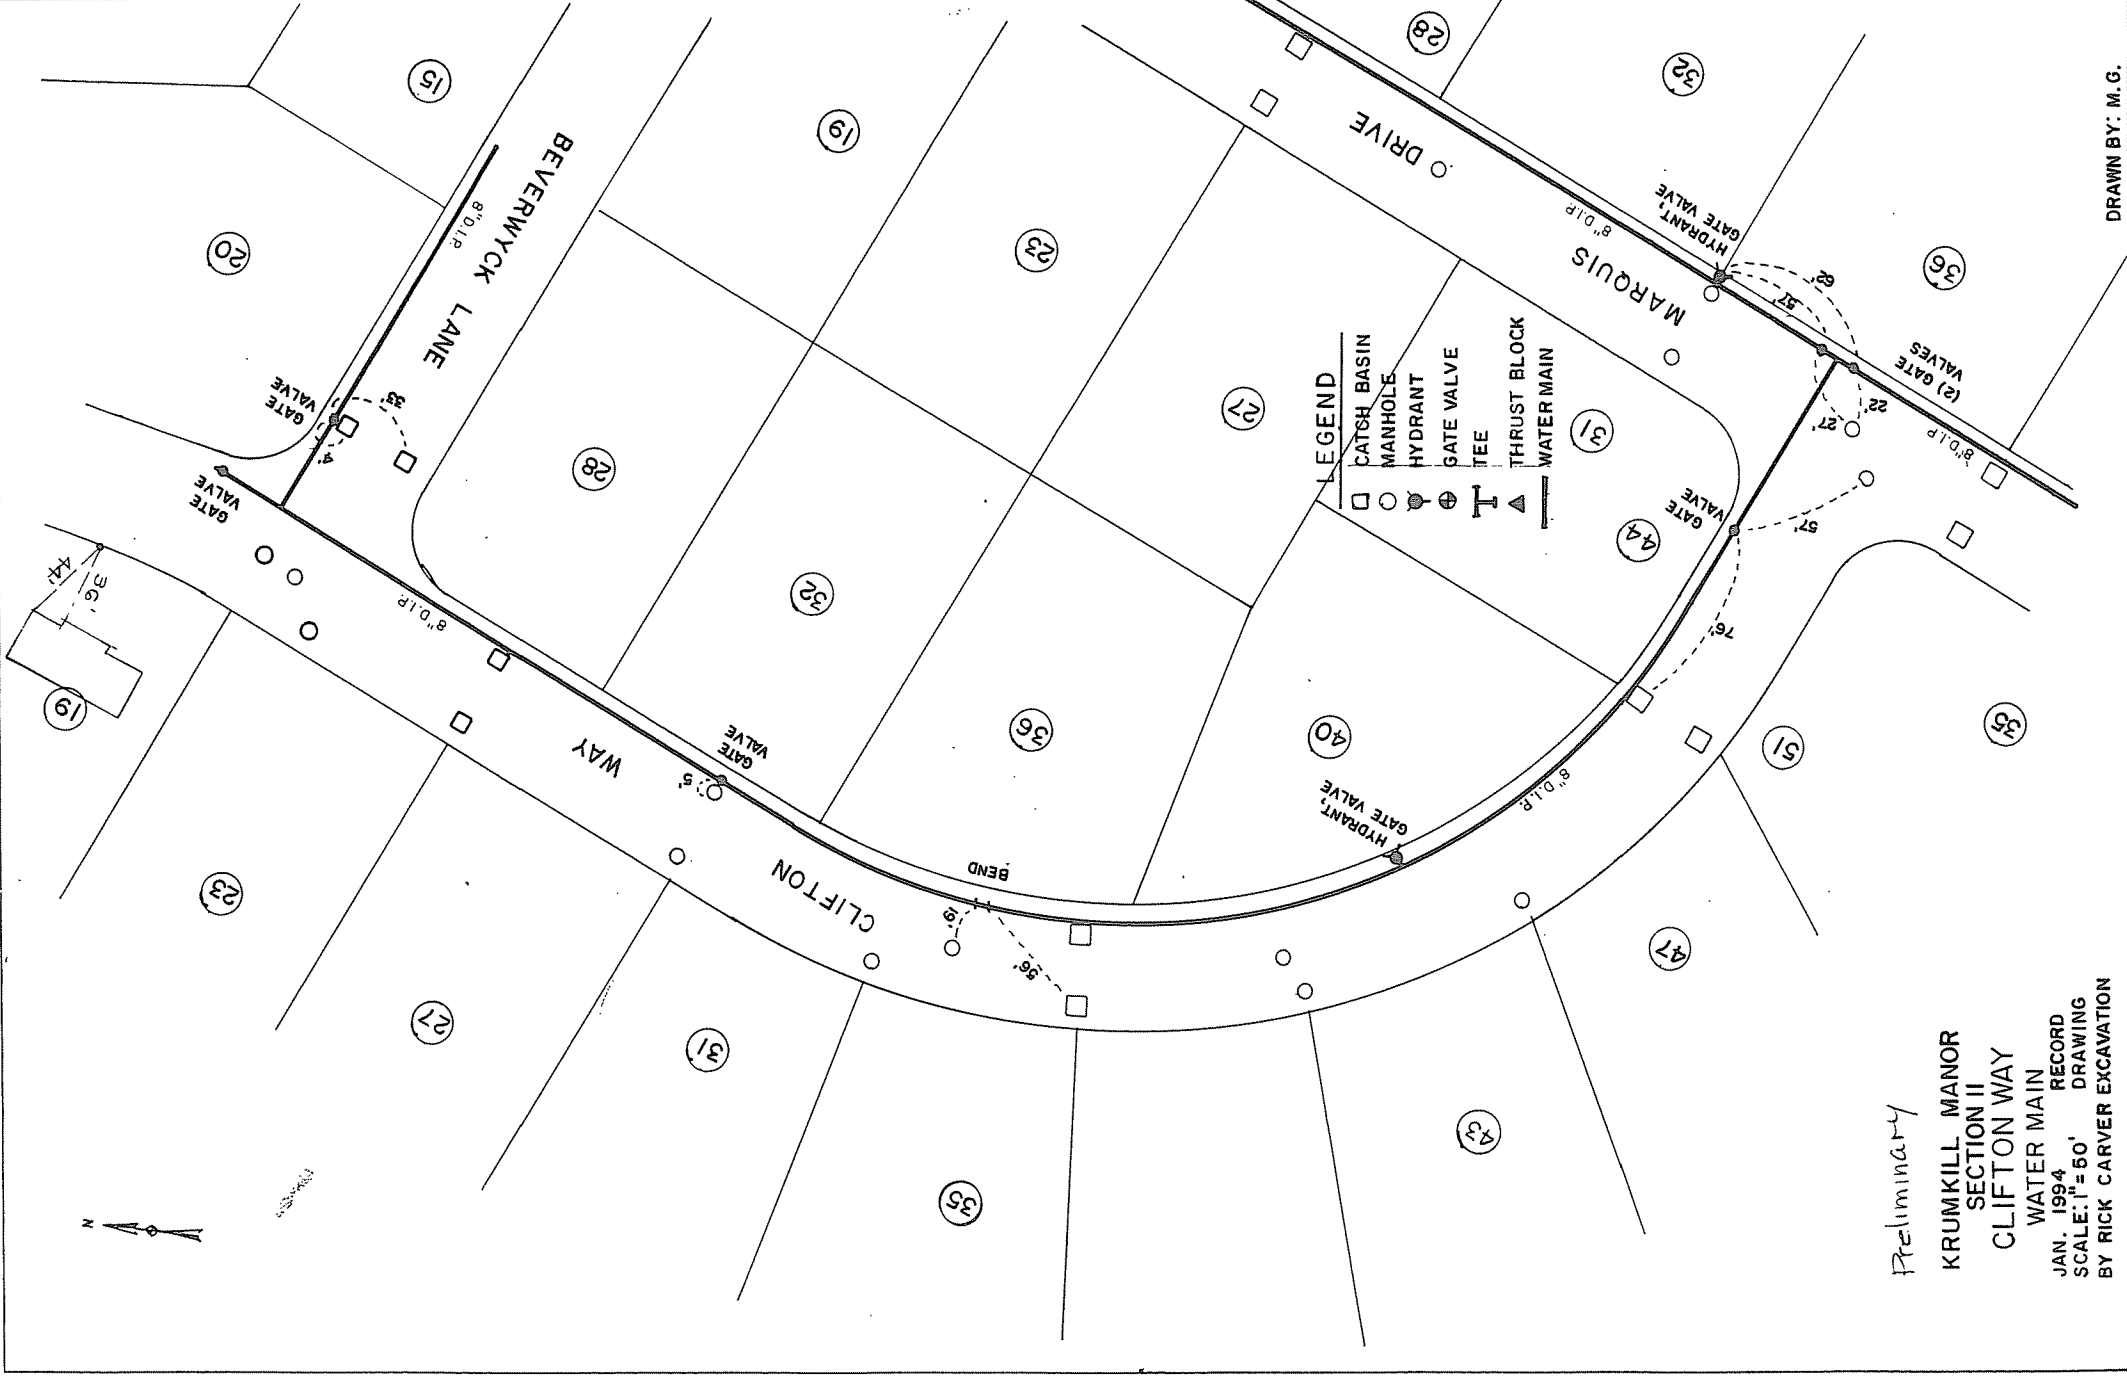

Preliminary
 KRUMKILL MANOR
 SECTION II
 CLIFTON WAY
 WATER MAIN
 JAN. 1994 RECORD
 SCALE: 1" = 50' DRAWING
 BY RICK CARVER EXCAVATION

DRAWN BY: M. G.