


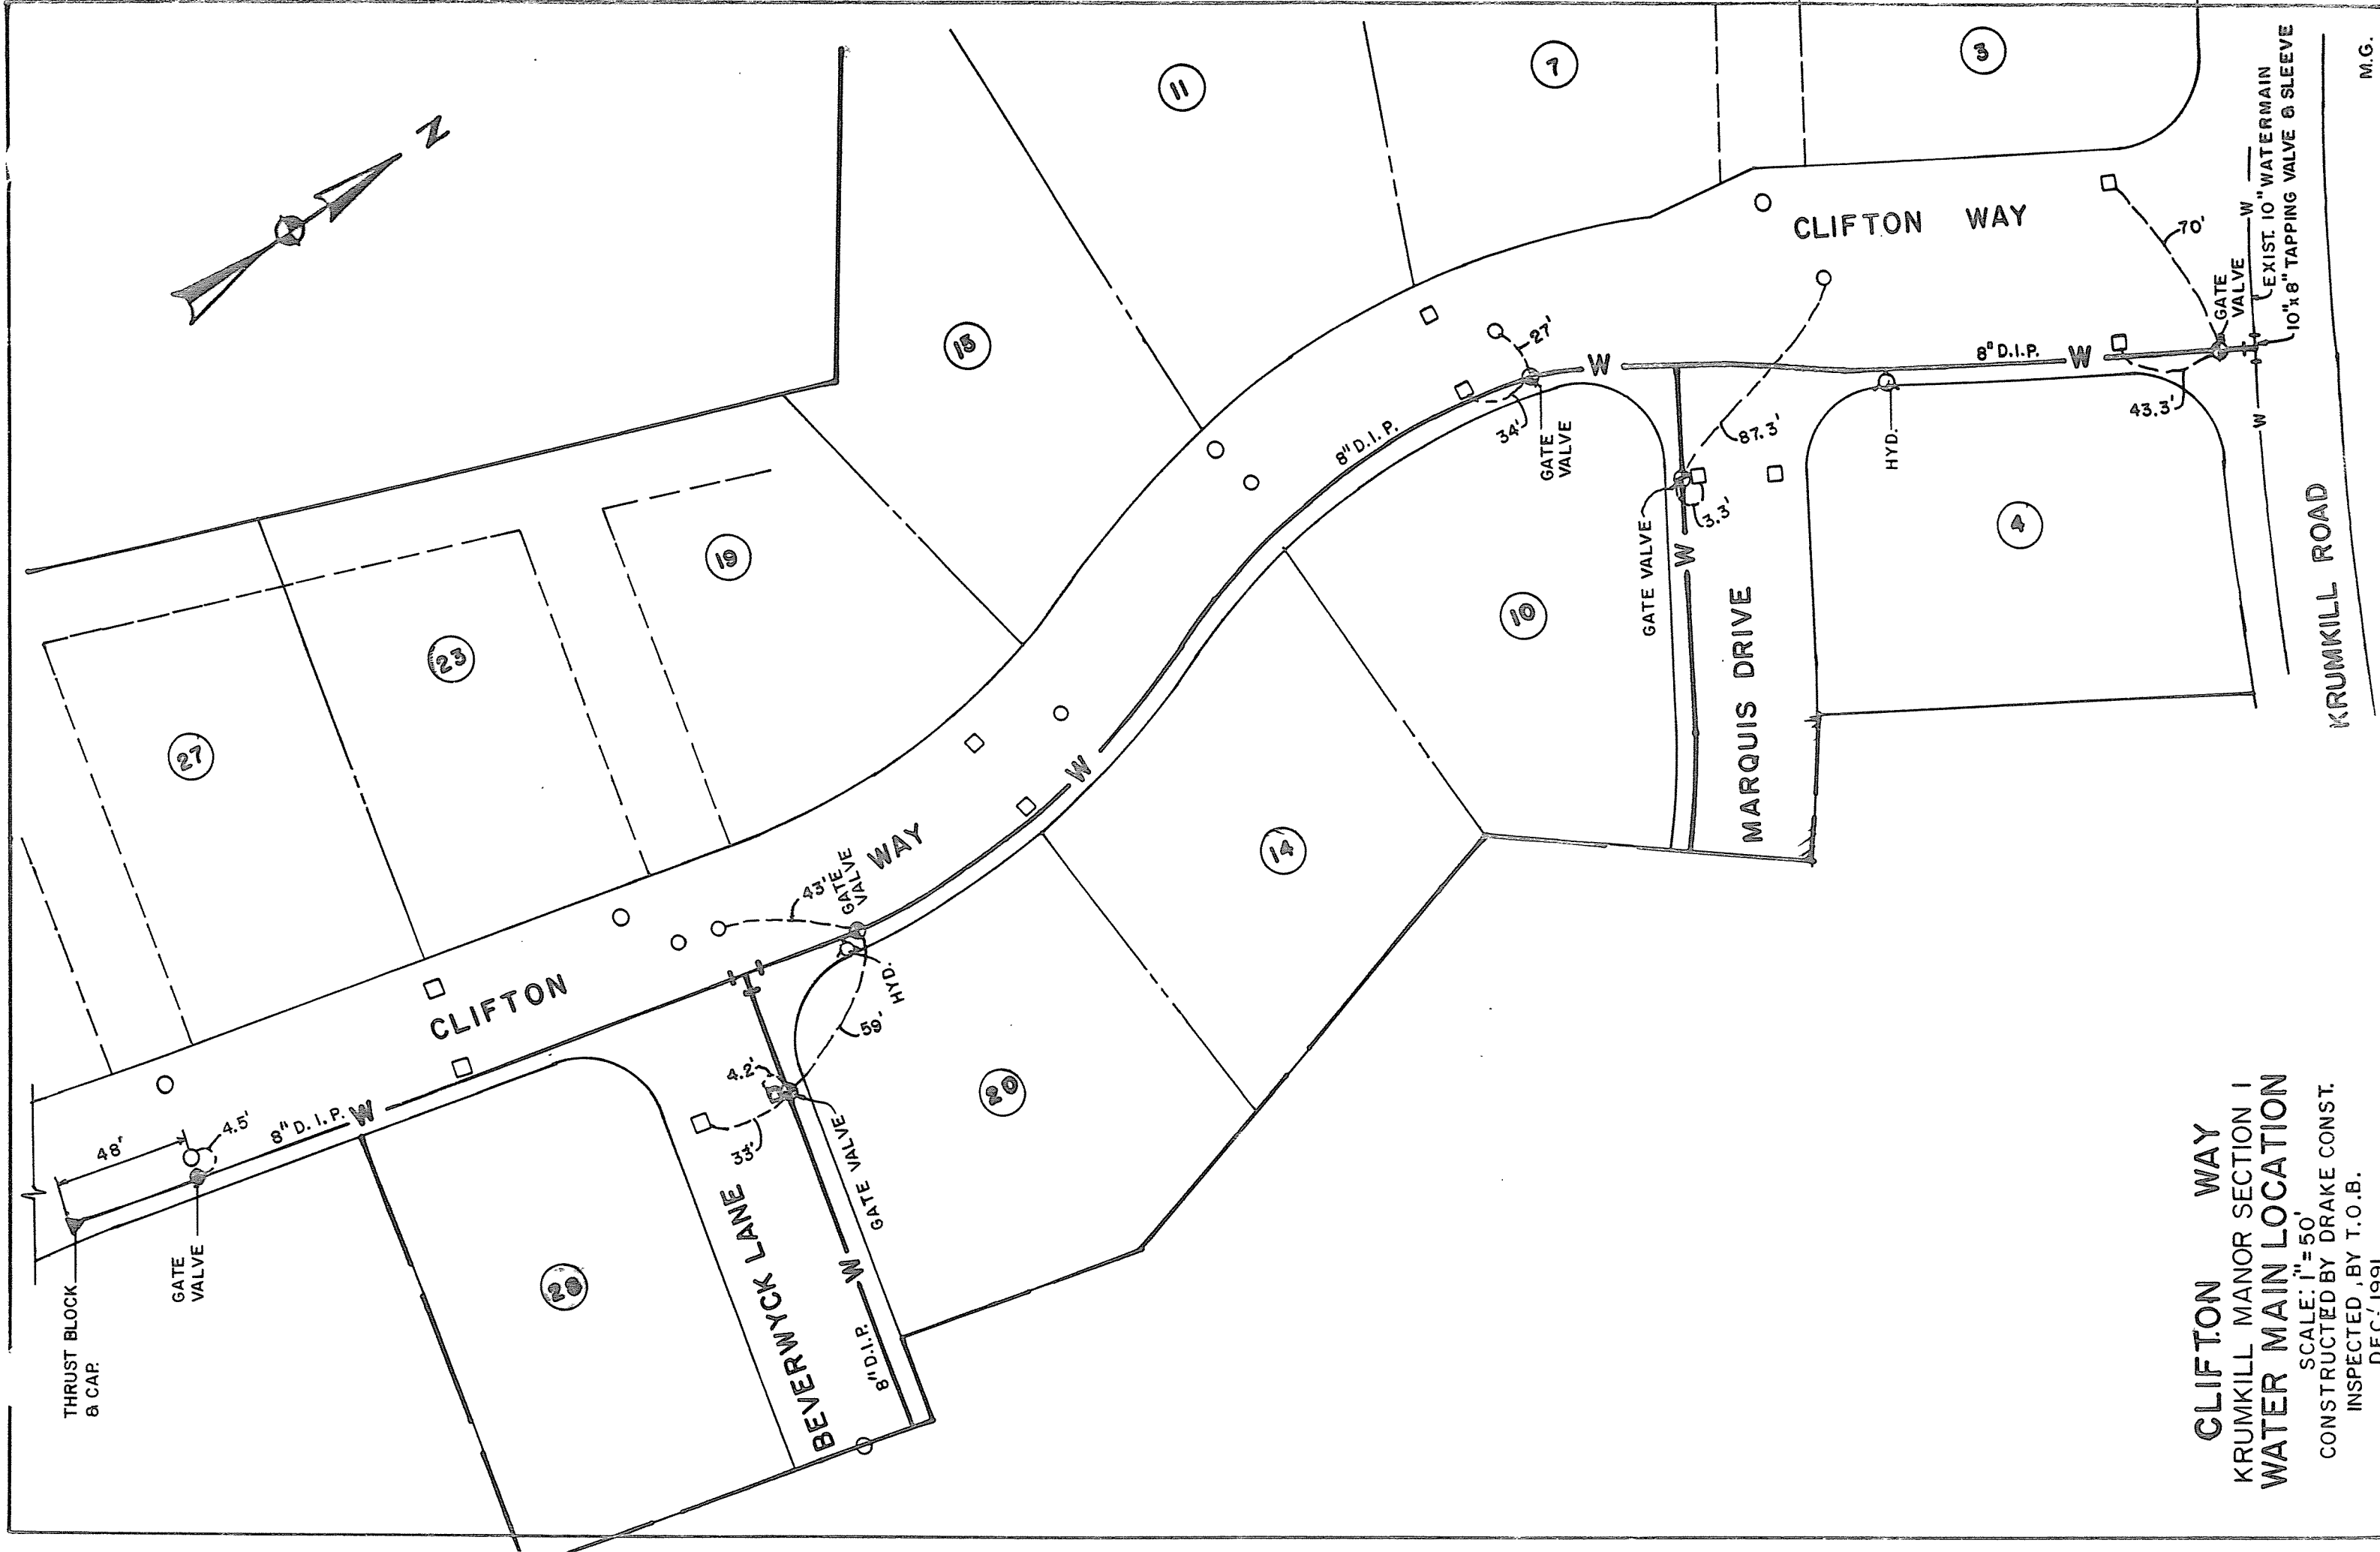

CLIFTON WAY
KRUMKILL MANOR SECTION I
WATER MAIN LOCATION
SCALE: 1"=50'
CONSTRUCTED BY DRAKE CONST.
INSPECTED BY T.O.B.
DEC. 1991