


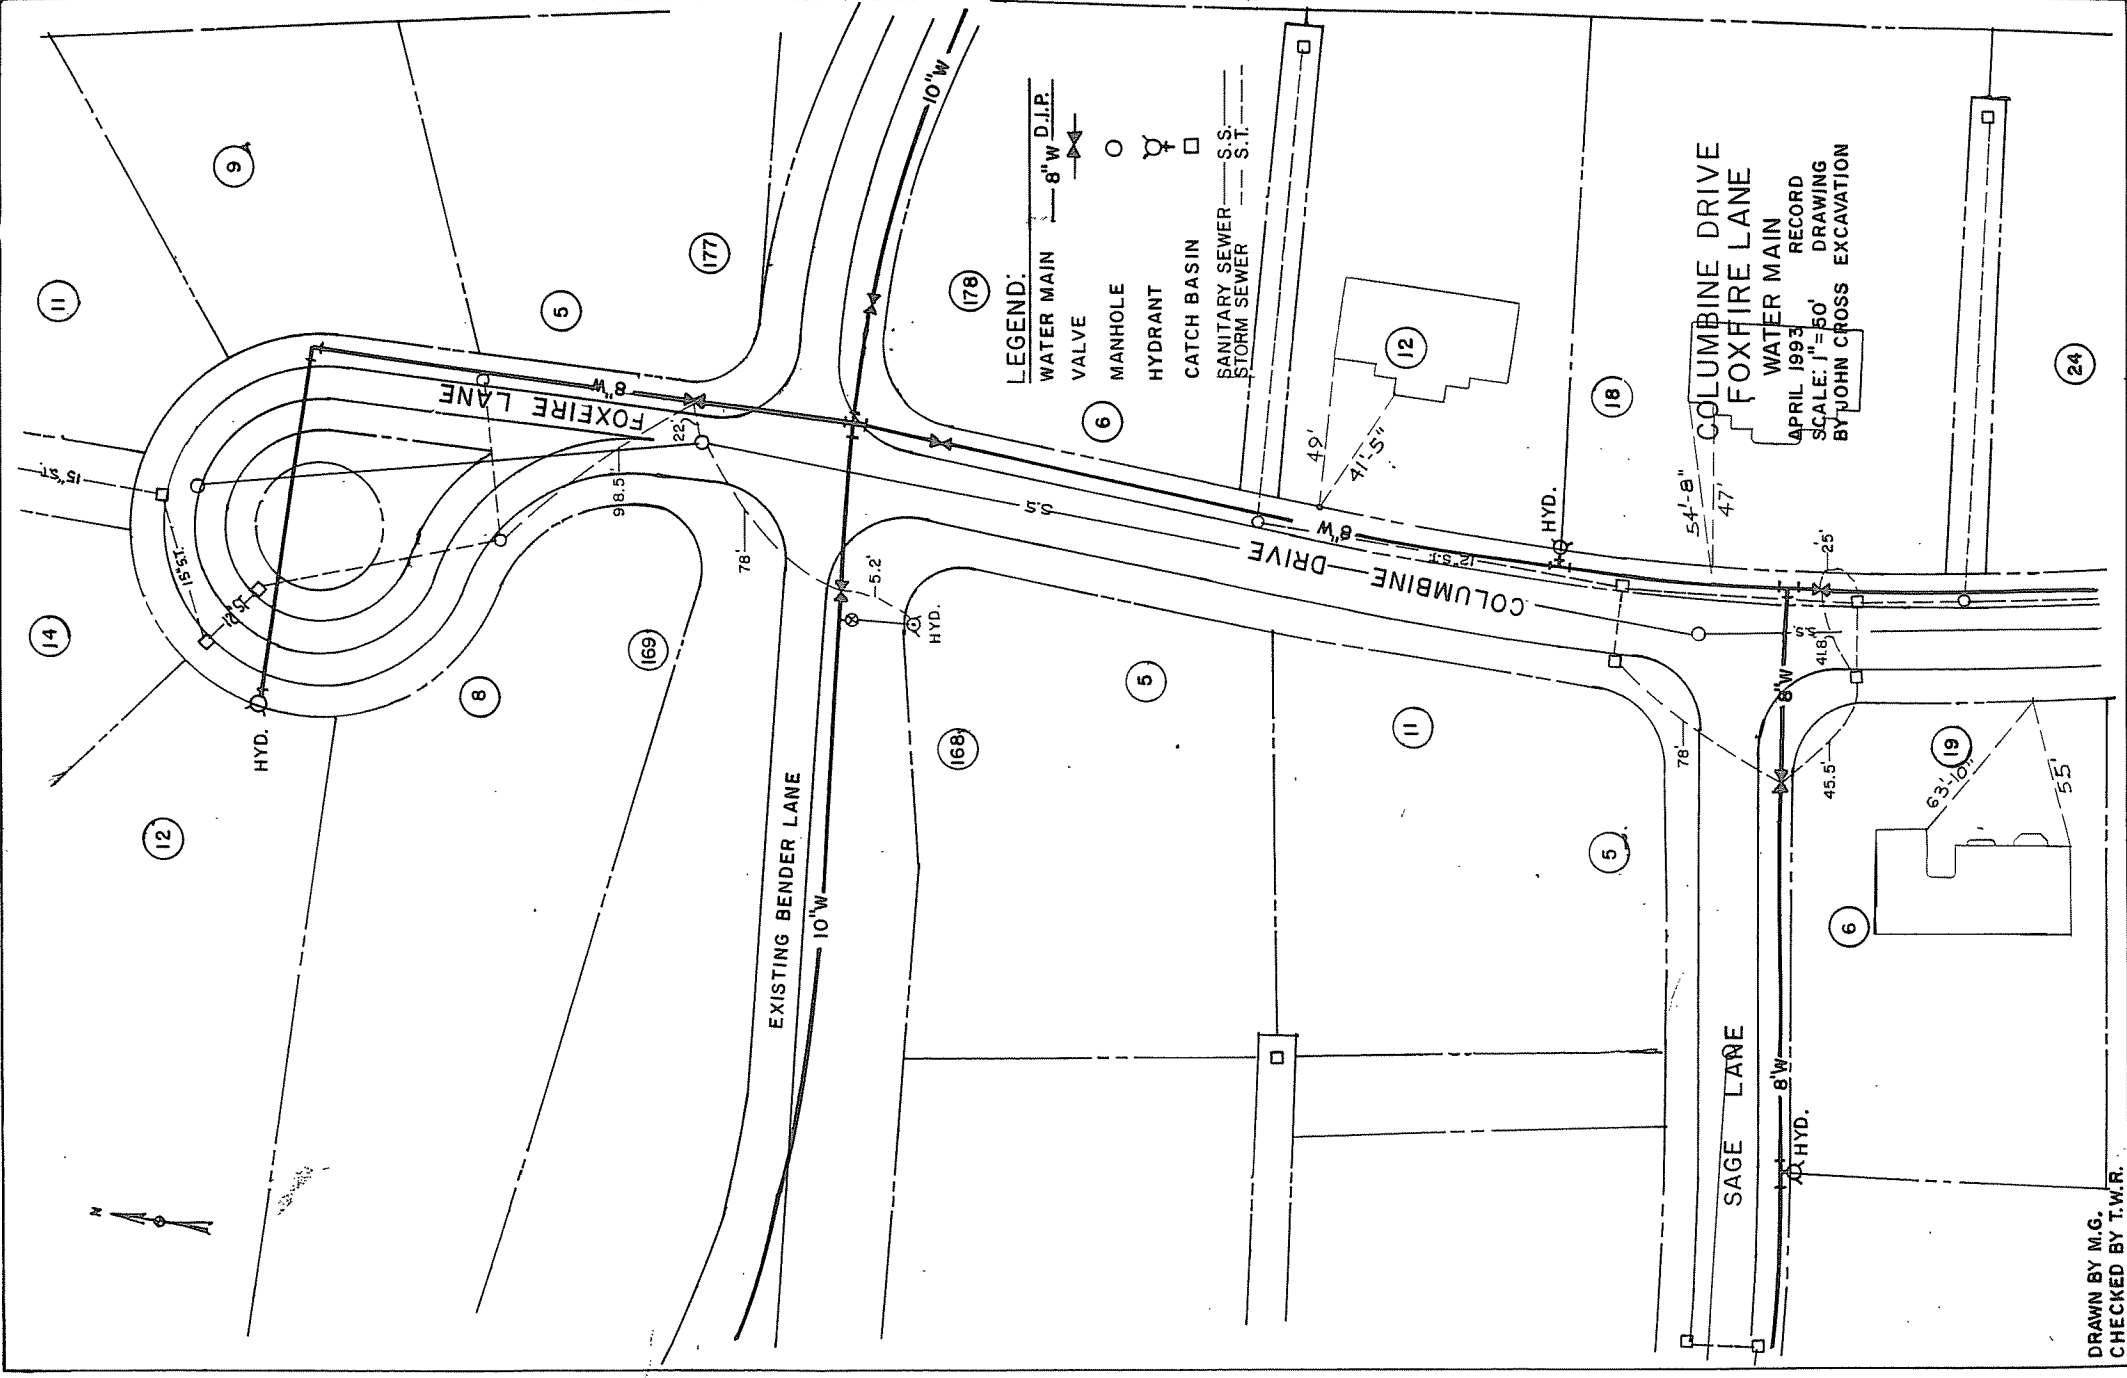

LEGEND:
WATER MAIN — 8" W D.I.P. —
VALVE —
MANHOLE —
HYDRANT —
CATCH BASIN —
SANITARY SEWER — S.S. —
STORM SEWER — S.T. —

COLUMBINE DRIVE
FOXFIRE LANE
WATER MAIN
APRIL 1993
RECORD
DRAWING
SCALE: 1"=50'
BY JOHN CROSS
EXCAVATION

DRAWN BY M.G.
CHECKED BY T.W.R.