


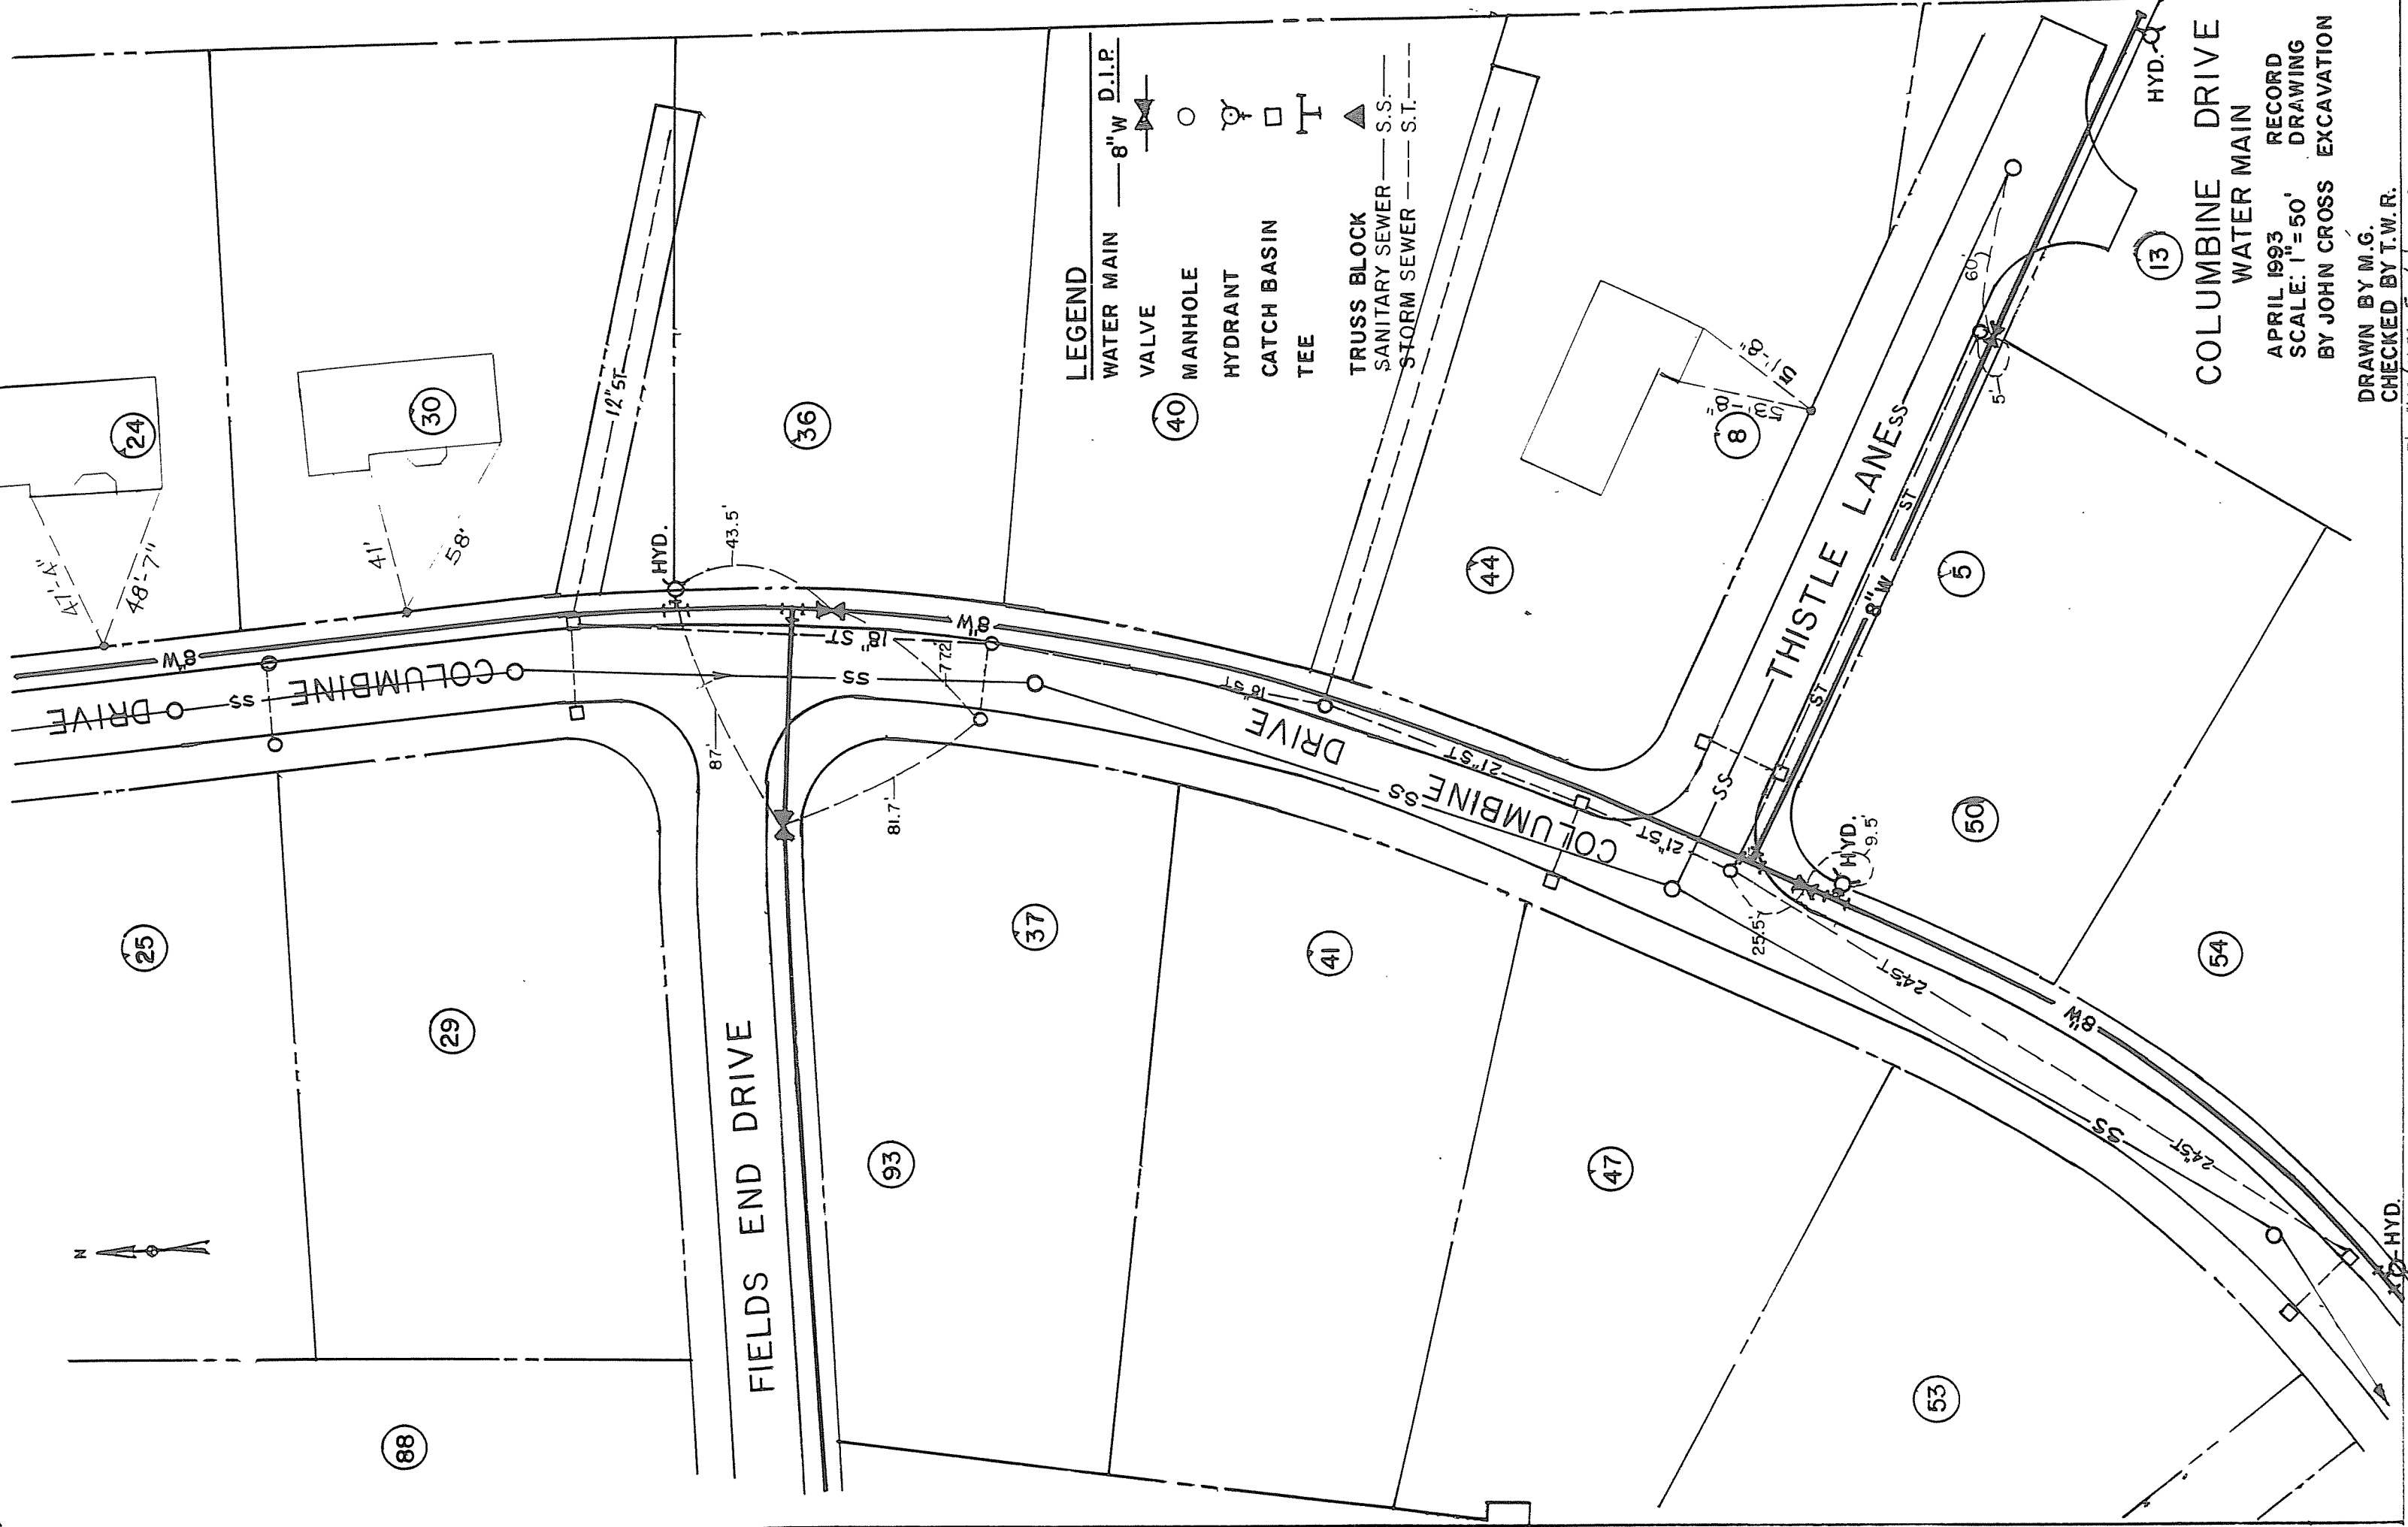

LEGEND

WATER MAIN — 8" W D.I.P.

VALVE

MANHOLE

HYDRANT

CATCH BASIN

TEE

TRUSS BLOCK

SANITARY SEWER — S.S.

STORM SEWER — S.T.

COLUMBINE DRIVE
WATER MAIN

APRIL 1993
SCALE: 1"=50'
BY JOHN CROSS
RECORD
DRAWING
EXCAVATION

DRAWN BY M.G.
CHECKED BY T.W.R.

The Woodward-Clyde