


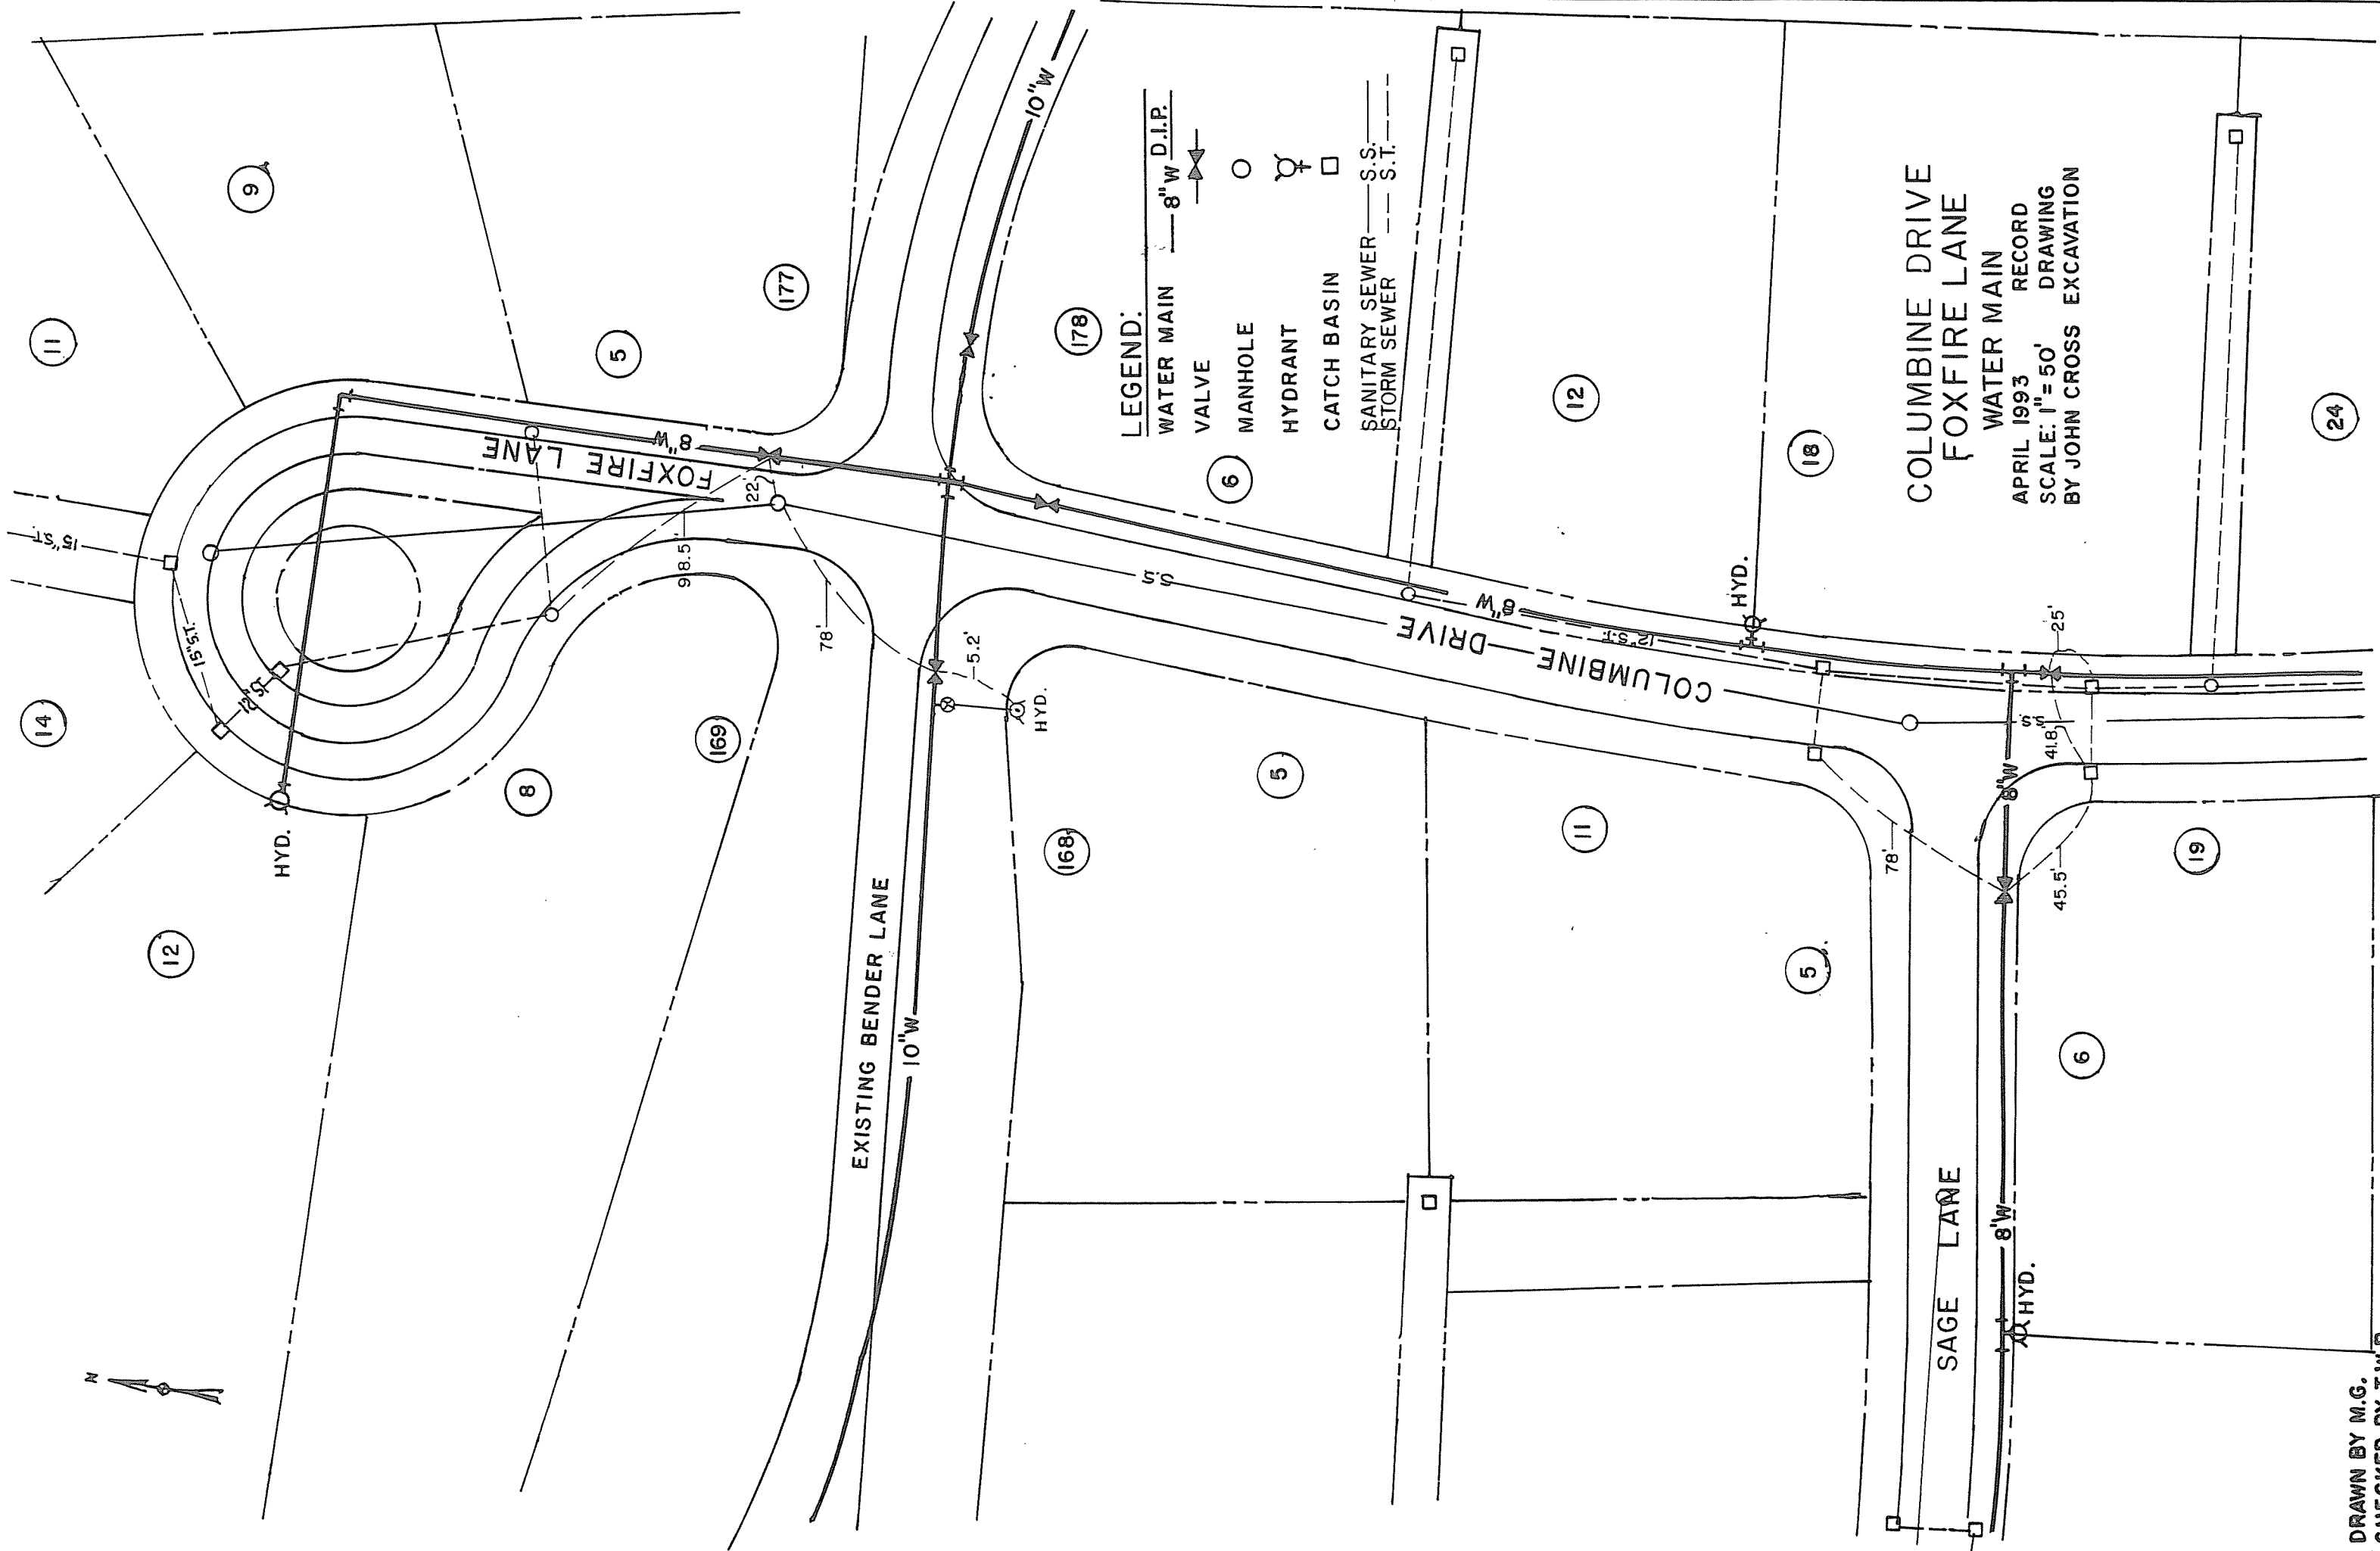

DRAWN BY M.G.
CHECKED BY T.W.R.

THE MEADOWS SUBDIVISION