


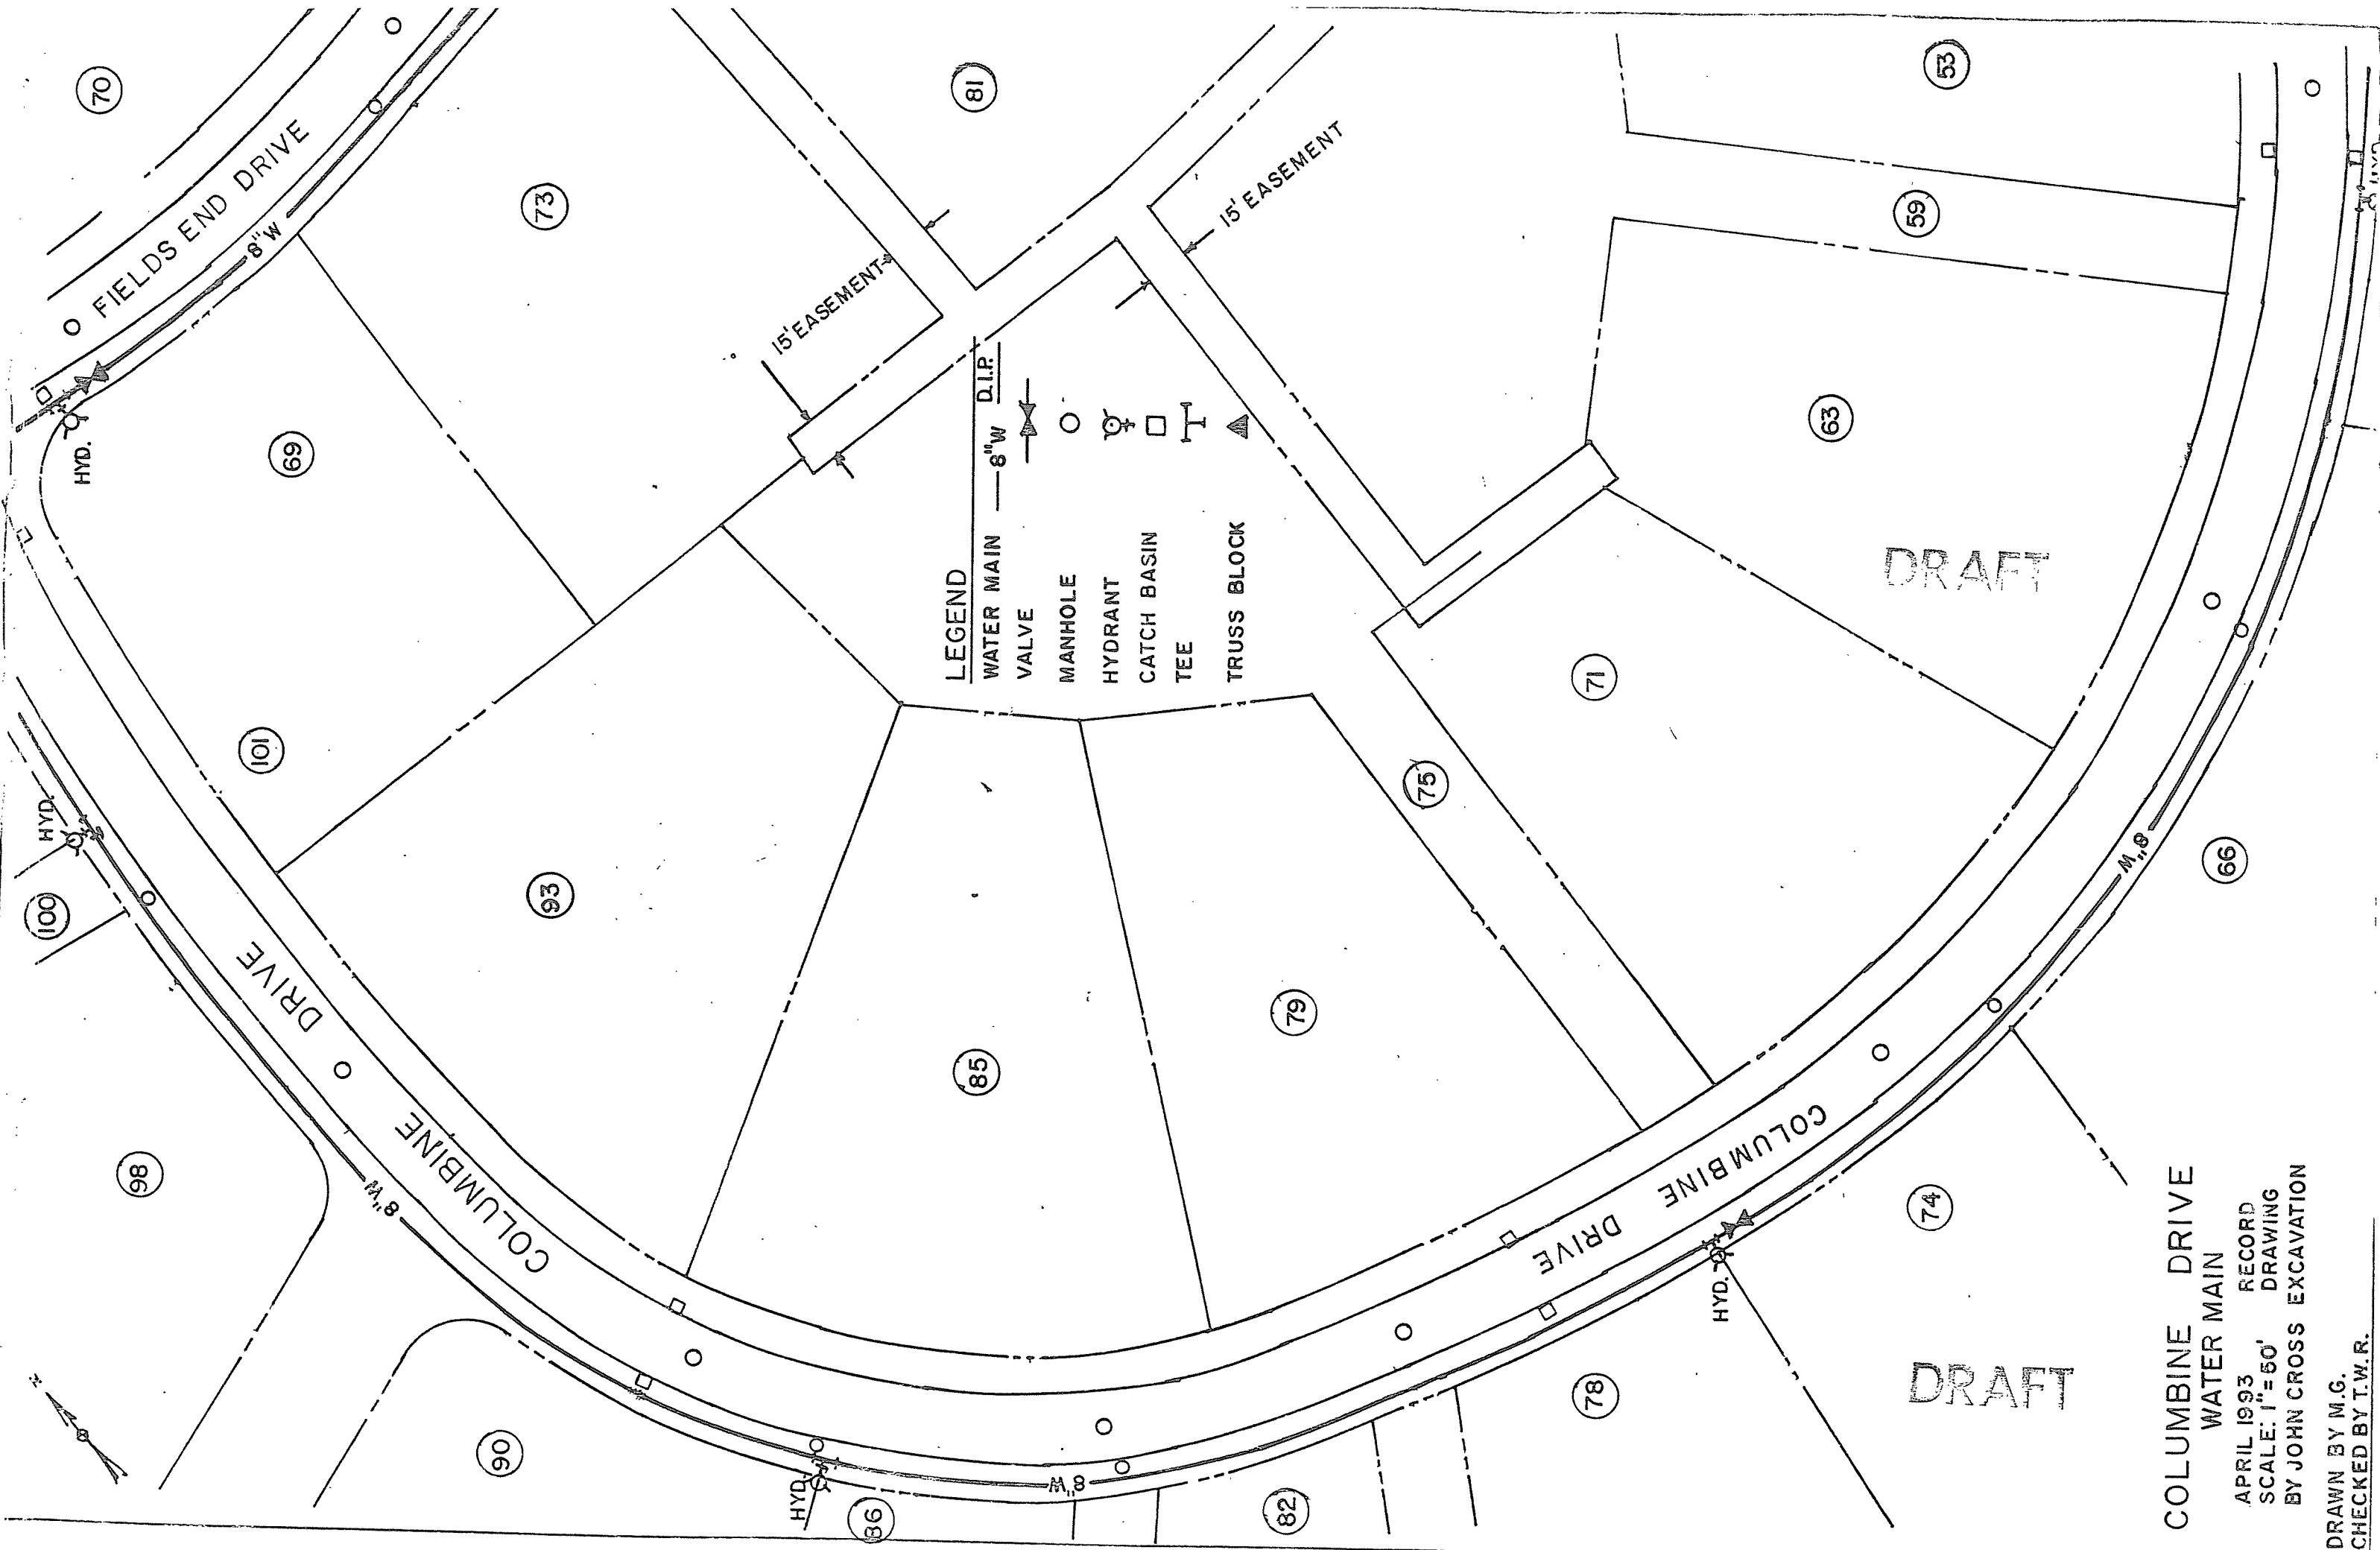

LEGEND

WATER MAIN — 8" W D.I.P.

VALVE

MANHOLE

HYDRANT

CATCH BASIN

TEE

TRUSS BLOCK

COLUMBINE DRIVE
WATER MAIN

APRIL 1993 RECORD
SCALE: 1"=60' DRAWING
BY JOHN CROSS EXCAVATION

DRAWN BY M.G.
CHECKED BY T.W.R.