

COMMONWEALTH DRIVE

WATER DISTRICT NO.1

TOWN OF BETHLEHEM



RECORD OF INSTALLATION

TOWN OF BETHLEHEM DEPARTMENT

OF ENGINEERING

SCALE: 1"= 20' JULY, 1984

DWN. BY AW

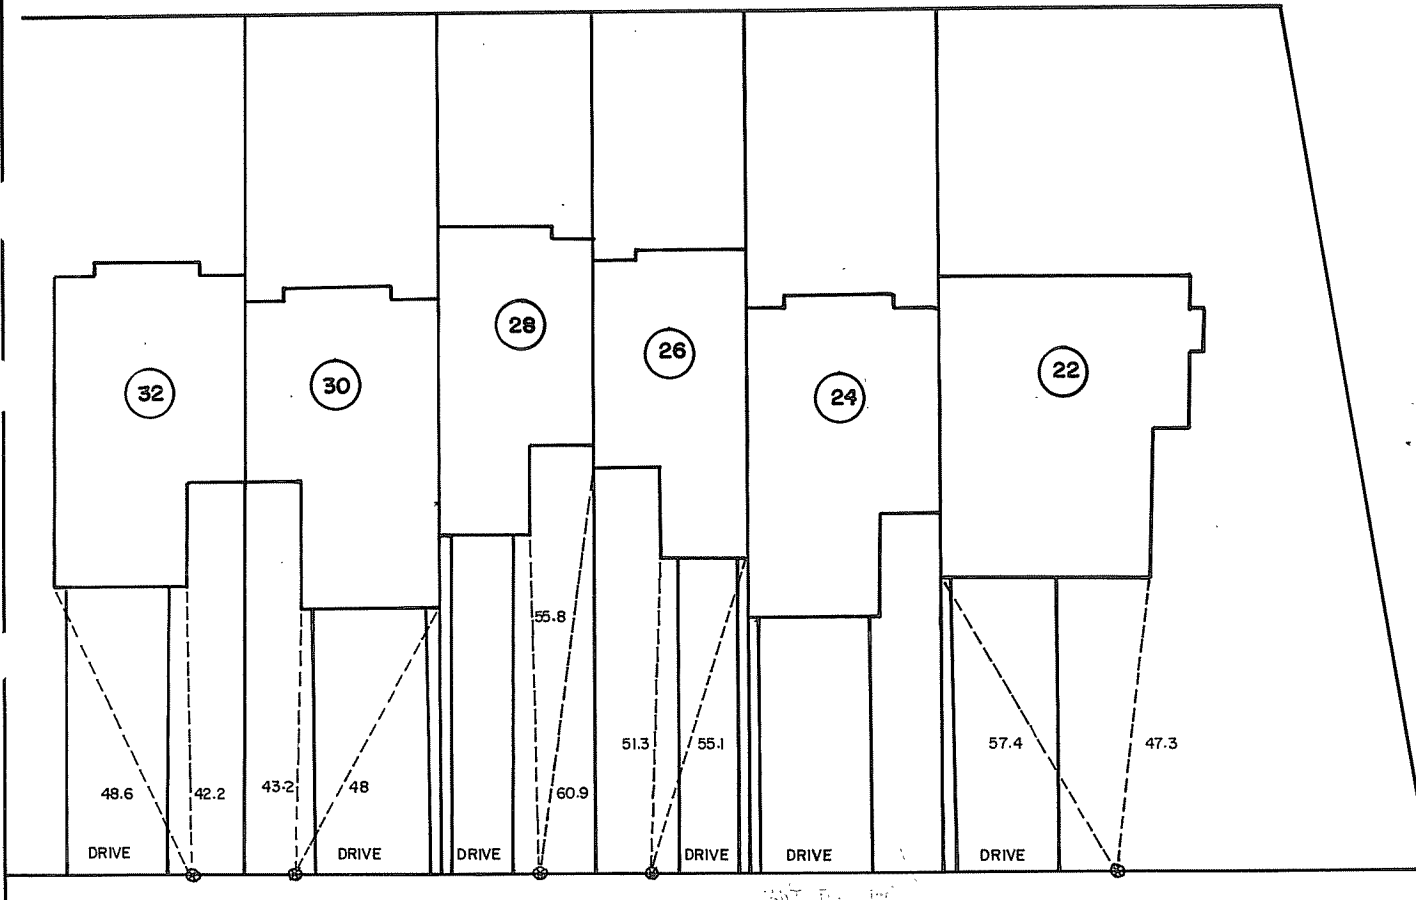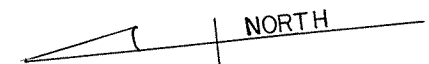

COMMONWEALTH

DRIVE