



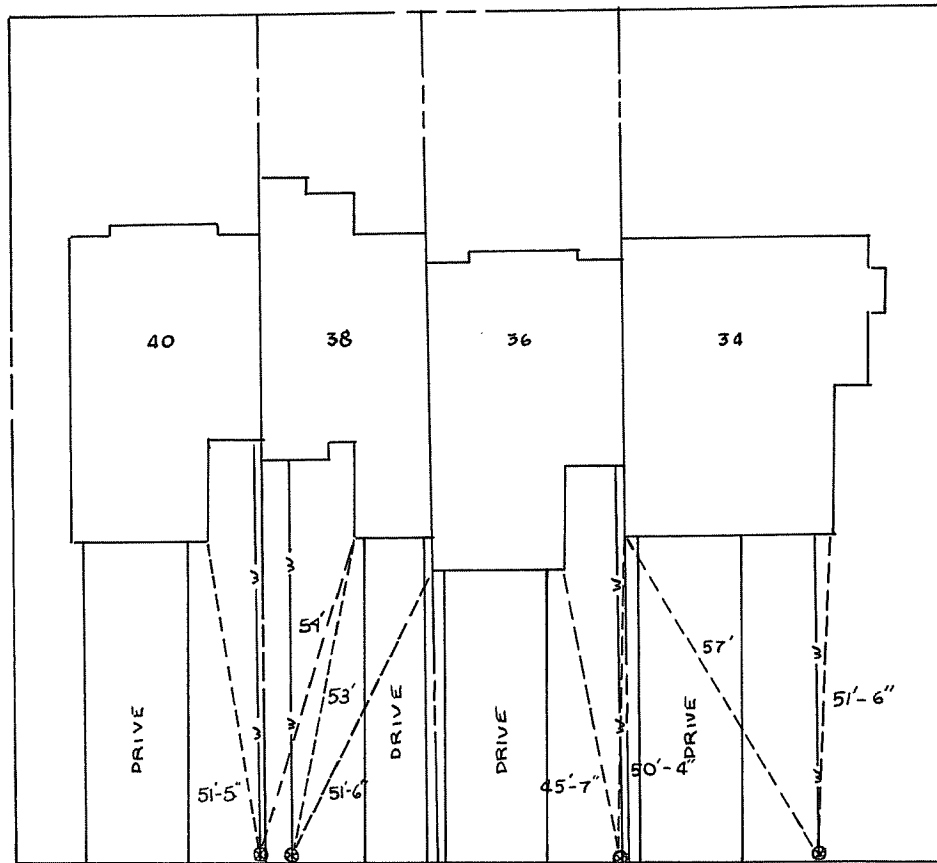

COMMONWEALTH DRIVE

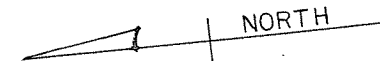

COMMONWEALTH

DRIVE

SCALE 1" = 20'	
DRAWN BY REB	
APPROVED.	
DATE.	
	TOWN OF BETHLEHEM ENGINEERING DEPARTMENT 448 DELAWARE AVE. DELMAR, NEW YORK 12006