



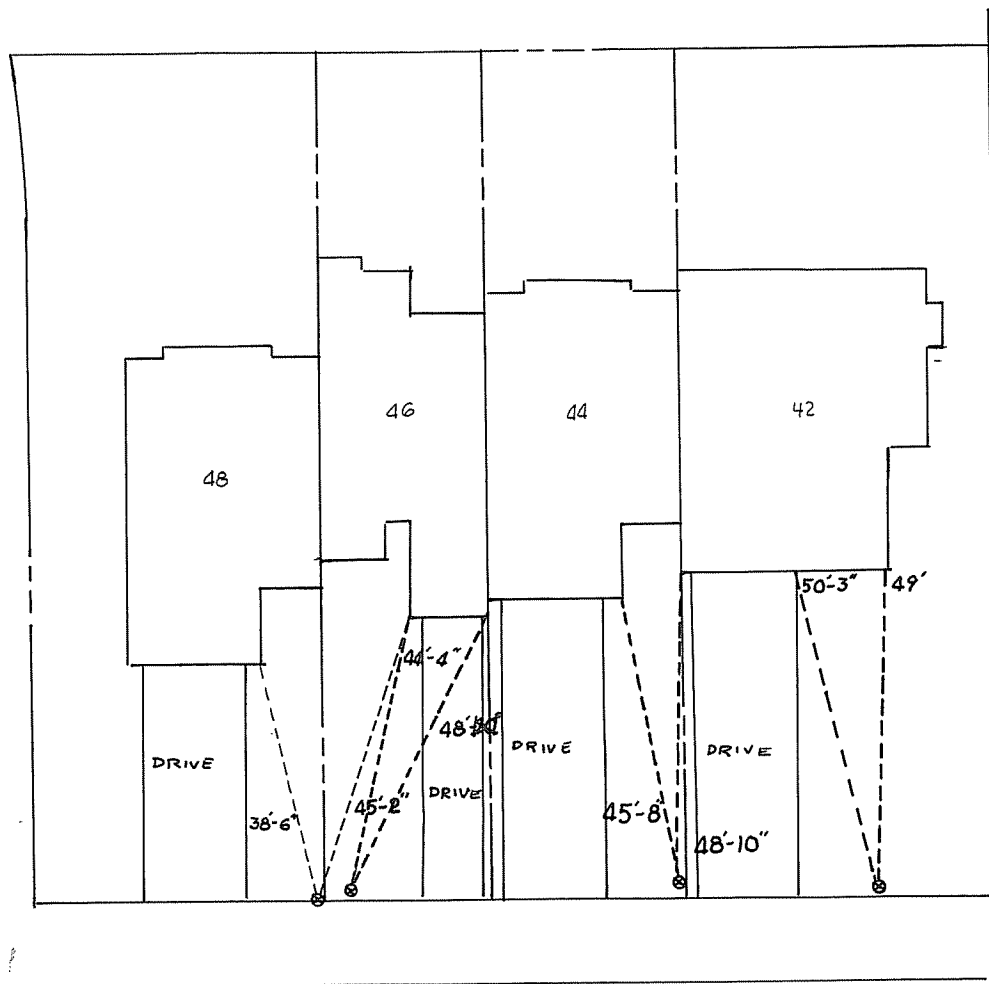

COMMONWEALTH DRIVE

COMMONWEALTH

DRIVE

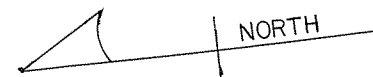

SCALE 1" = 20'		DRAWING NUMBER
DRAWN BY REB		
APPROVED		
DATE		
		TOWN OF WETHERSFIELD ENGINEERING DEPARTMENT 100 STATE ST., SUITE 200, WETHERSFIELD, CT 06094