



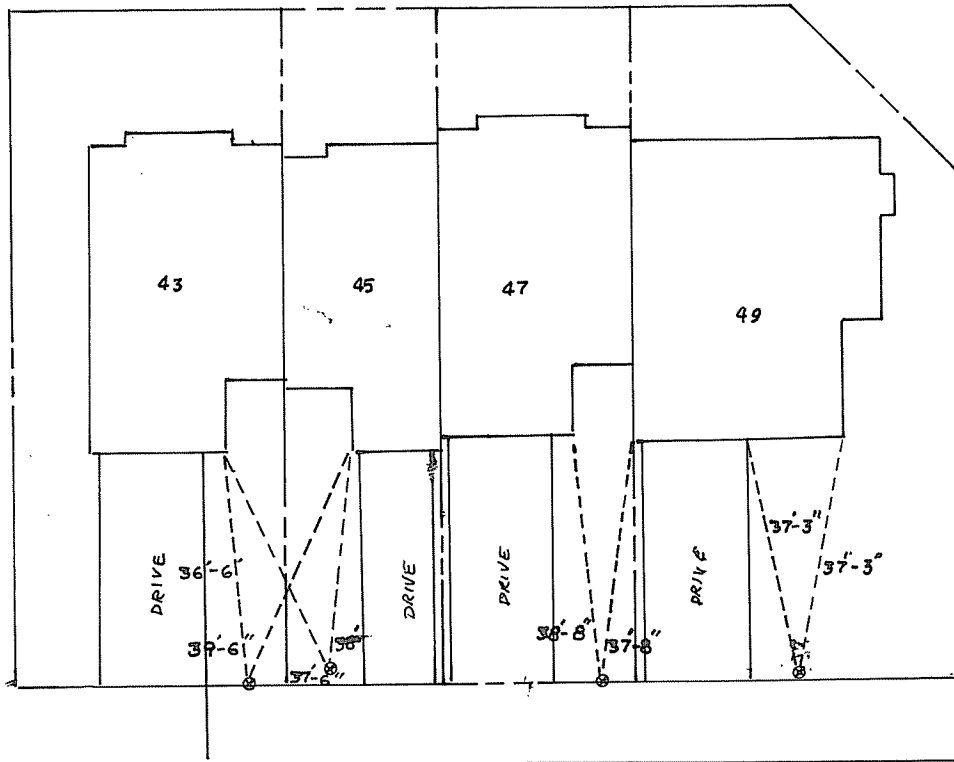

COMMONWEALTH
DRIVE

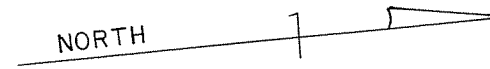

SCALE. 1" = 20'		DRAWING NUMBER
DRAWN BY. R E B		
APPROVED.		
DATE.		
		THOMAS J. STEPHEN ENGINEERING & ARCHITECT 448 DELAWARE AVE. DELAWARE, NEW YORK 12034

COMMONWEALTH DRIVE