



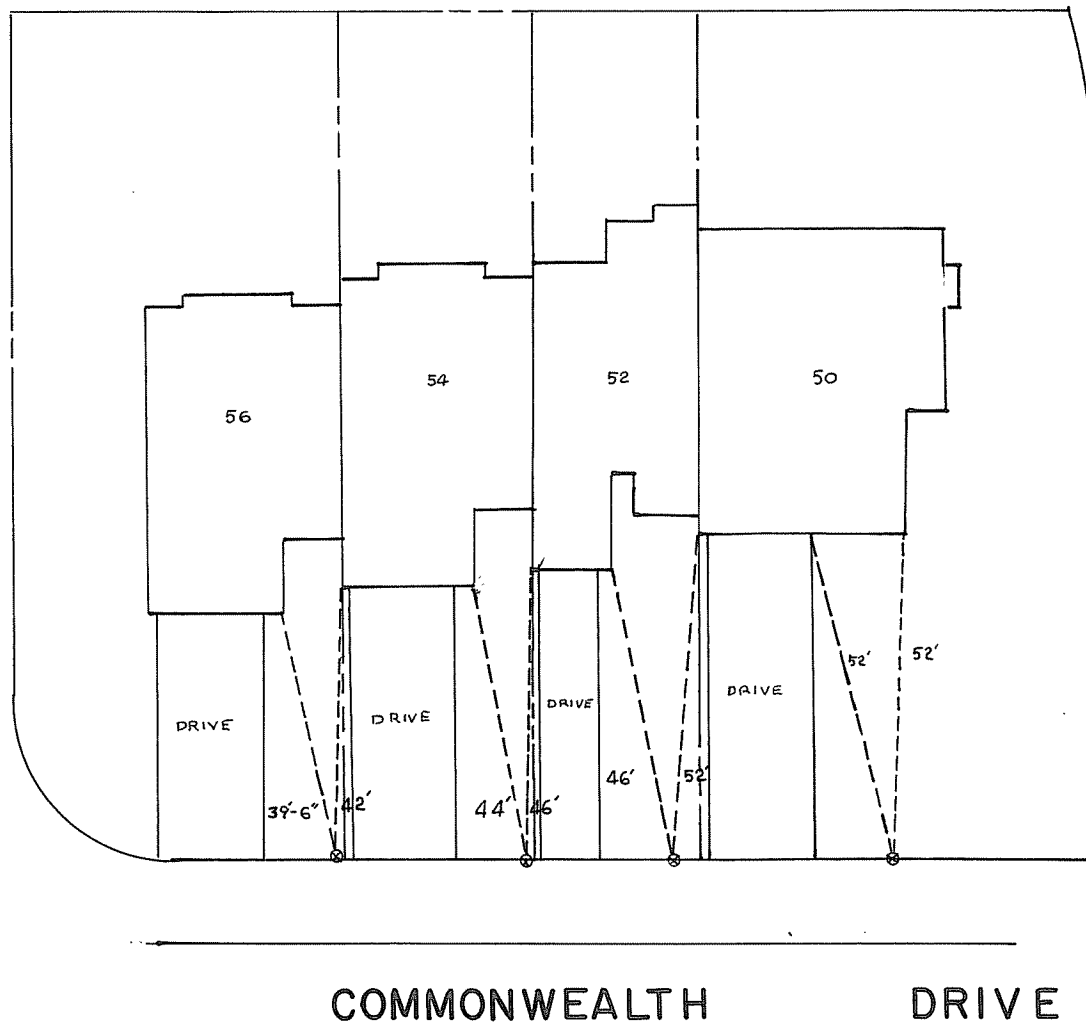

COMMONWEALTH
DRIVE

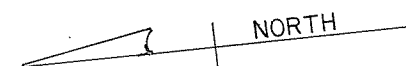

SCALE, " 1" = 20'	
DRAWN BY: REB	
APPROVED:	
DATE:	
	TOWN OF BETHLEHEM
	ENGINEERING DEPARTMENT
	547 DELAWARE AVE. DELMAR, NEW YORK 12054