

# COMMONWEALTH DRIVE

WATER DISTRICT NO. 1

TOWN OF BETHLEHEM

## RECORD OF INSTALLATION

TOWN OF BETHLEHEM ENGINEERING DEPT.

SCALE 1"=50' AUGUST, 1986

DWN. BY JEM

NORTH

DRIVE




COMMONWEALTH

DRIVE

RUSFIELD

ROAD

BRIGHTWOOD

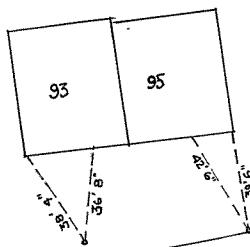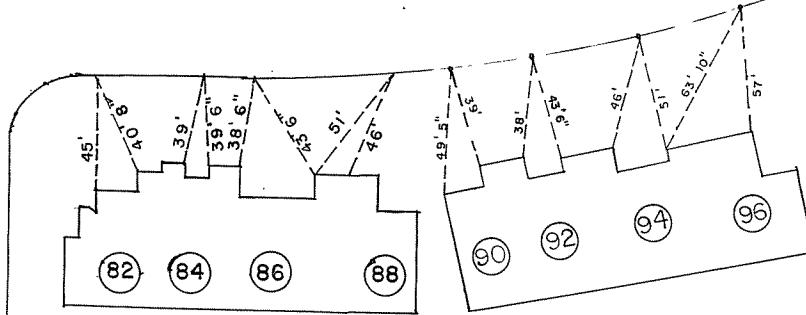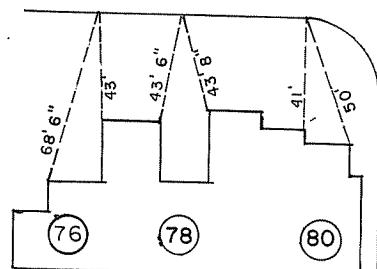

COMMONWEALTH DRIVE

WATER DISTRICT NO. 1

TOWN OF BETHLEHEM

## RECORD OF INSTALLATION

TOWN OF BETHLEHEM ENGINEERING DEPT.

SCALE 1"=50' AUGUST, 1986

DWN. BY JEM

NORTH

DRIVE

COMMONWEALTH

DRIVE

RUSFIELD

ROAD

BRIGHTWOOD

