


MATCHLINE "A"

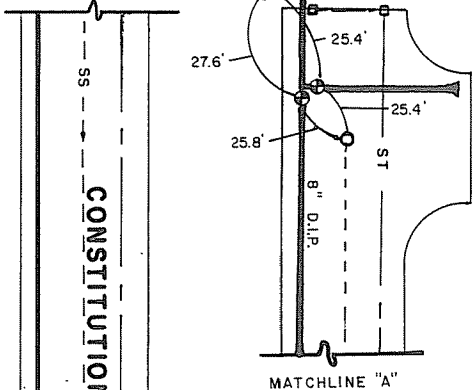

STANDISH DRIVE

LEGEND

- CATCH BASIN
- MANHOLE
- ⊙ HYDRANT
- ⊕ GATE VALVE
- ⊥ TEE
- ▲ THRUST BLOCK
- W — WATER MAIN

CONSTITUTION DRIVE

DRIVE

CONSTITUTION COURT

LINE VALVE, UNFOUNDED

could not find

YORK ROAD

8" D.I.P.

could not find

COMMONWEALTH DRIVE

DRIVE

CONSTITUTION CT.

&

YORK ROAD

WATER MAIN LOCATION

SCALE: 1" = 50'

22 1/2° BEND

20'

70'