


- LEGEND
- CATCH BASIN
 - MANHOLE
 - ⊙ HYDRANT
 - ⊕ GATE VALVE
 - ⊥ TEE
 - ▲ THRUST BLOCK
 - W— WATER MAIN

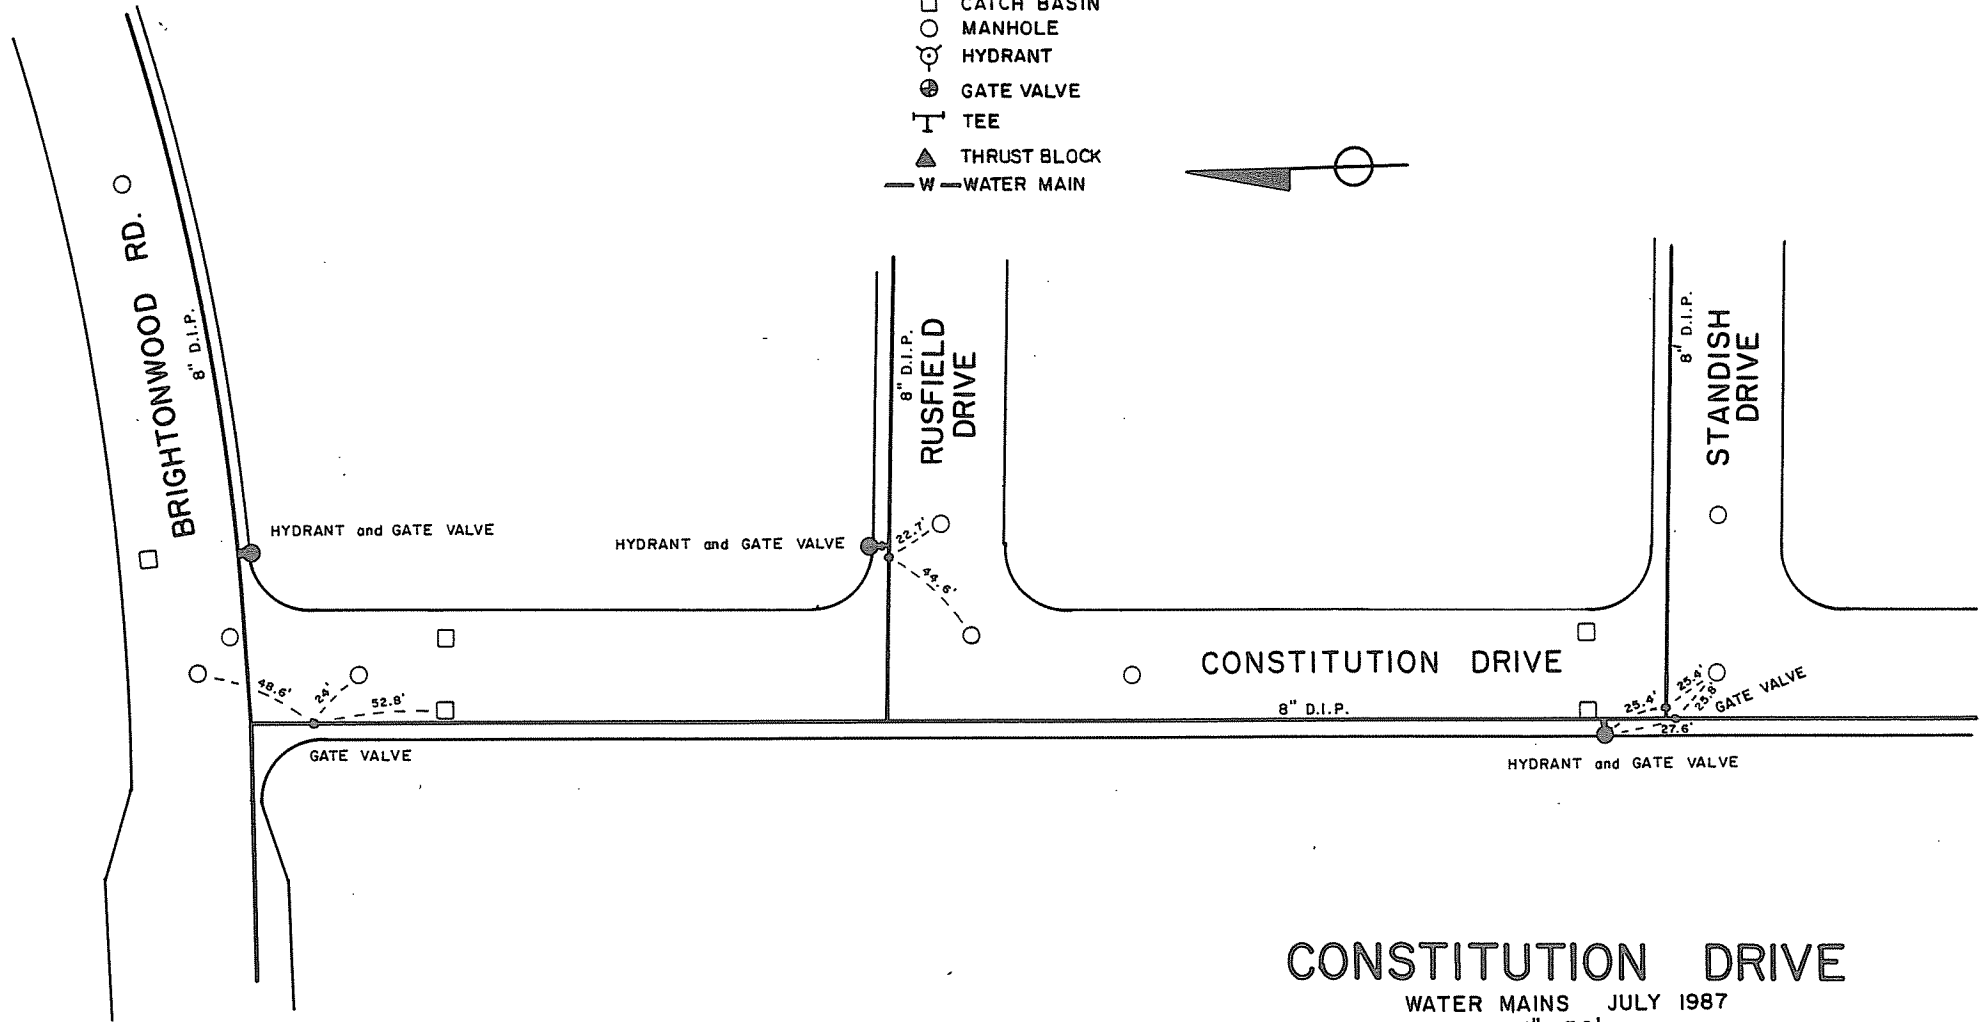

CONSTITUTION DRIVE

WATER MAINS JULY 1987
1" = 50'