


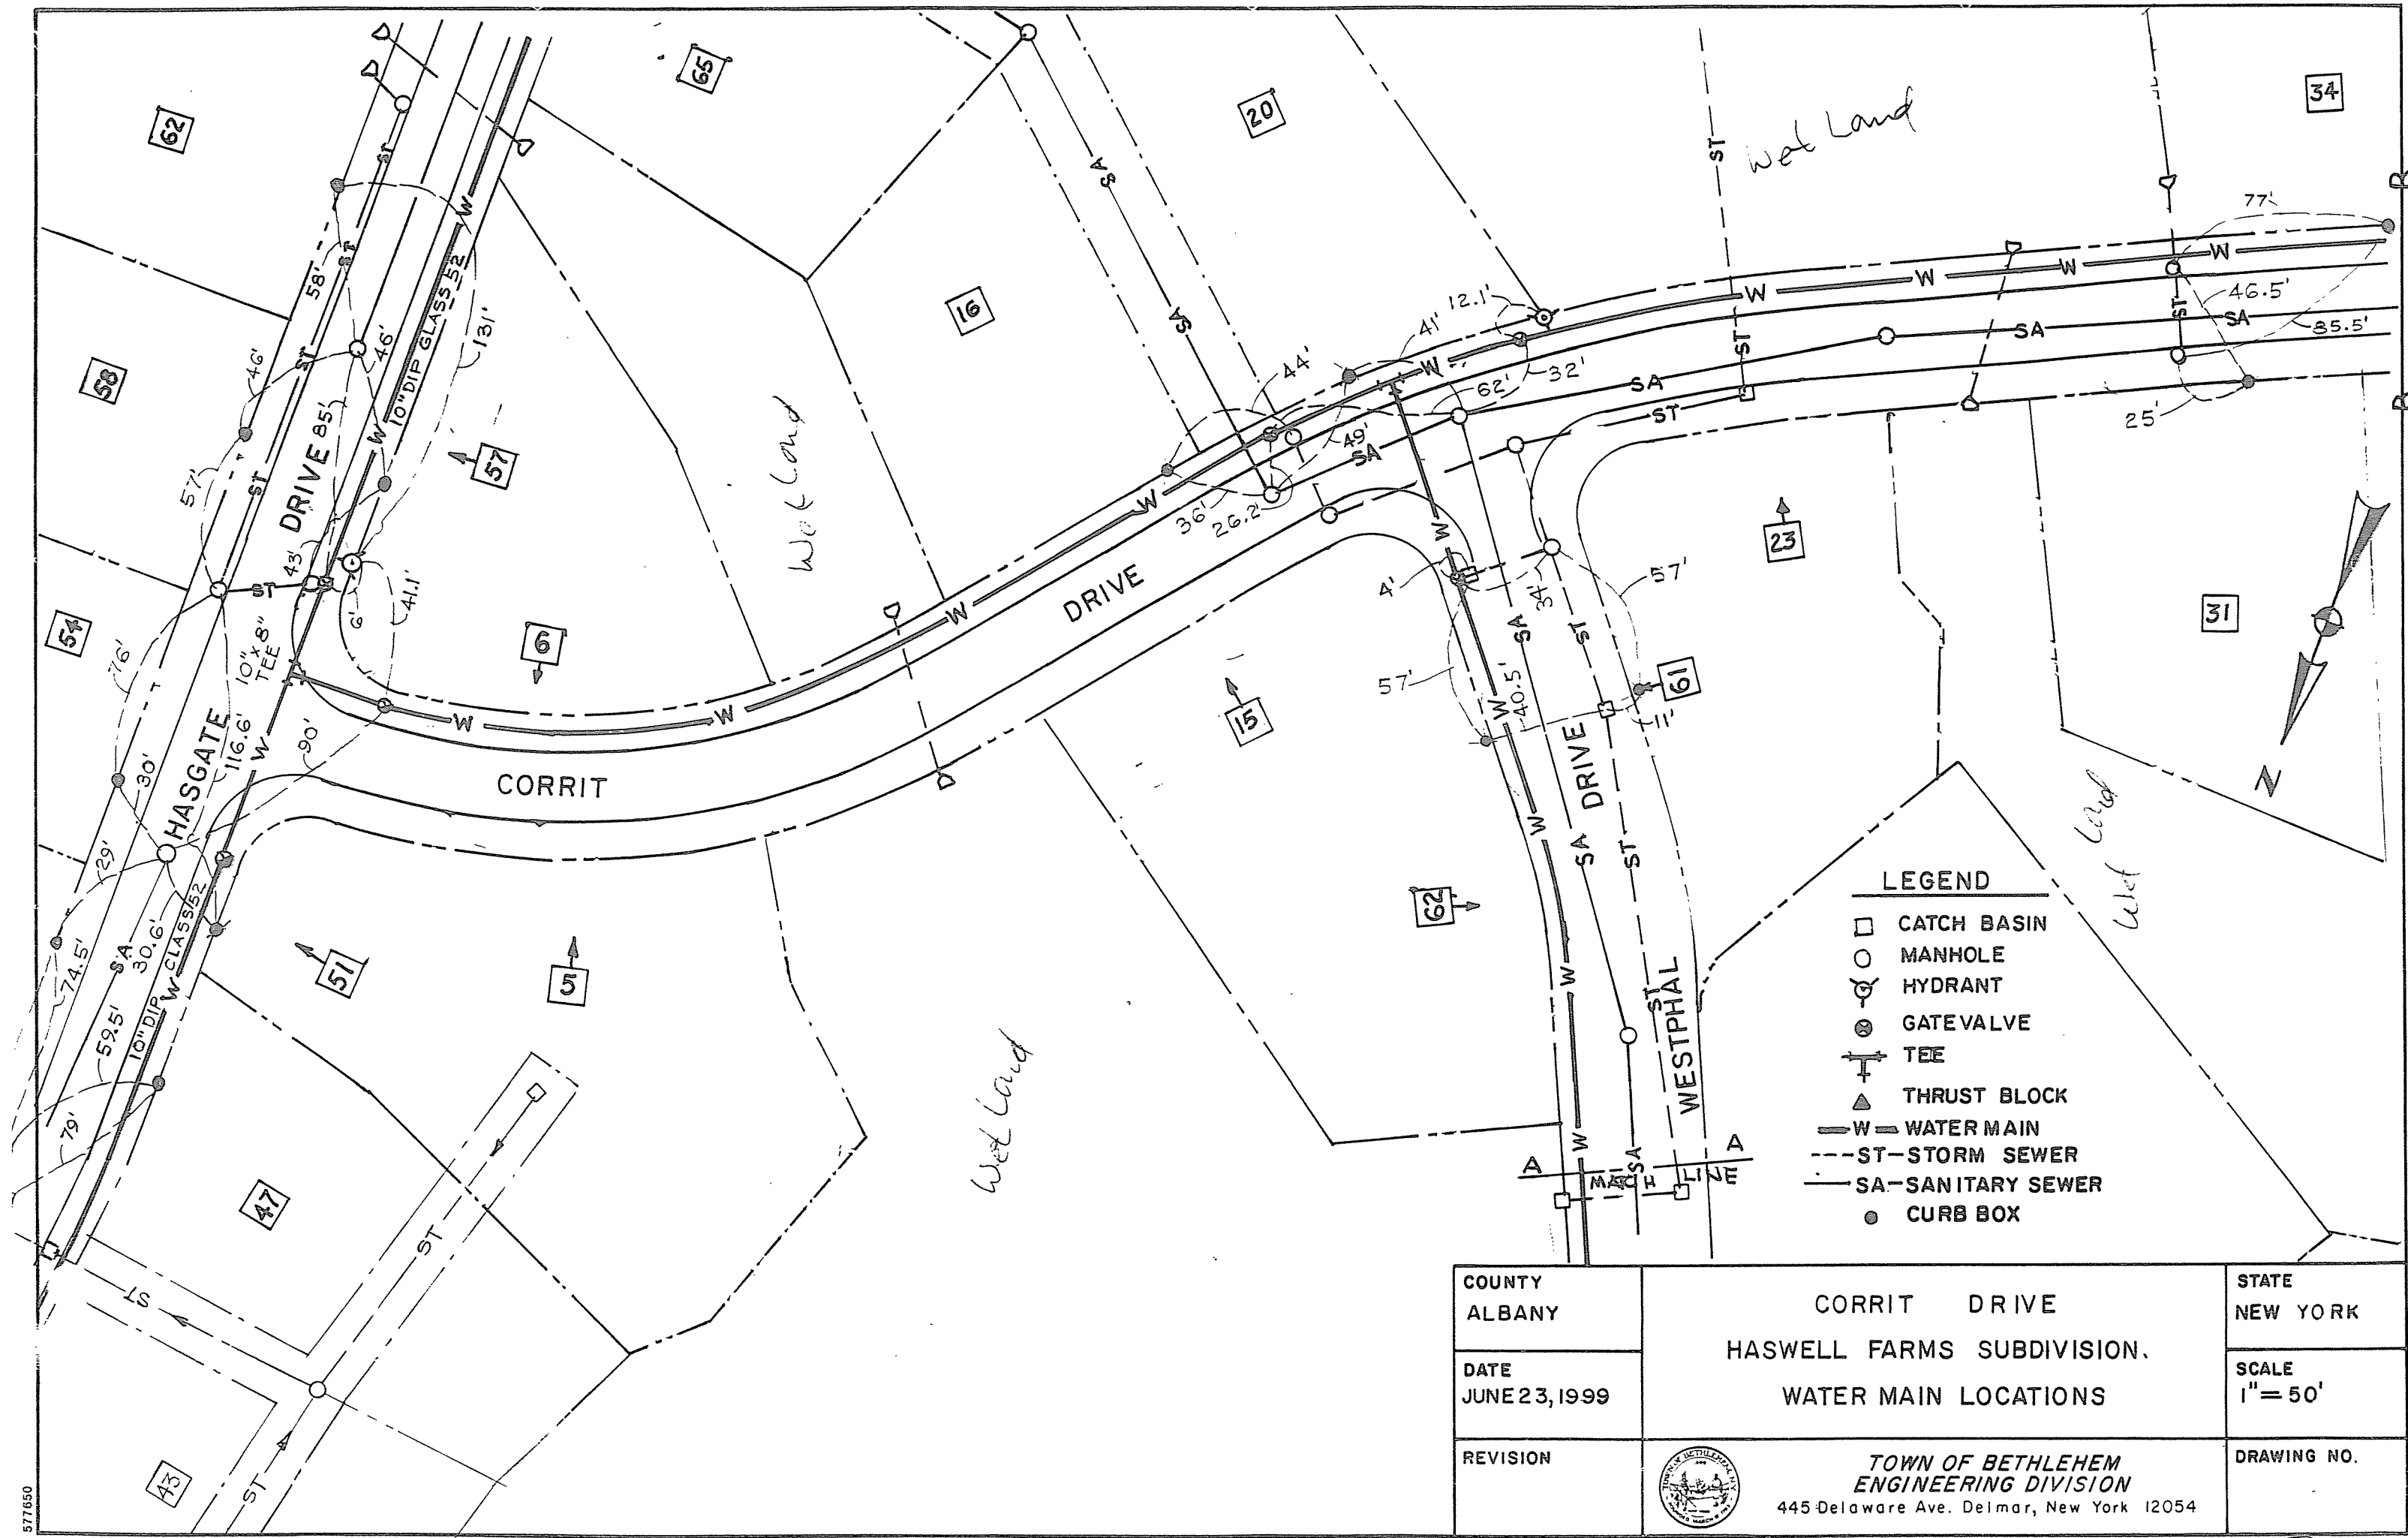

LEGEND

- CATCH BASIN
- MANHOLE
- ⊗ HYDRANT
- ⊗ GATE VALVE
- ⊕ TEE
- ▲ THRUST BLOCK
- W — WATER MAIN
- - - ST - STORM SEWER
- - - SA - SANITARY SEWER
- CURB BOX

COUNTY ALBANY	CORRIT DRIVE HASWELL FARMS SUBDIVISION. WATER MAIN LOCATIONS	STATE NEW YORK
DATE JUNE 23, 1999		SCALE 1" = 50'
REVISION	 TOWN OF BETHLEHEM ENGINEERING DIVISION 445 Delaware Ave. Delmar, New York 12054	DRAWING NO.

HASWELL FARMS 44