


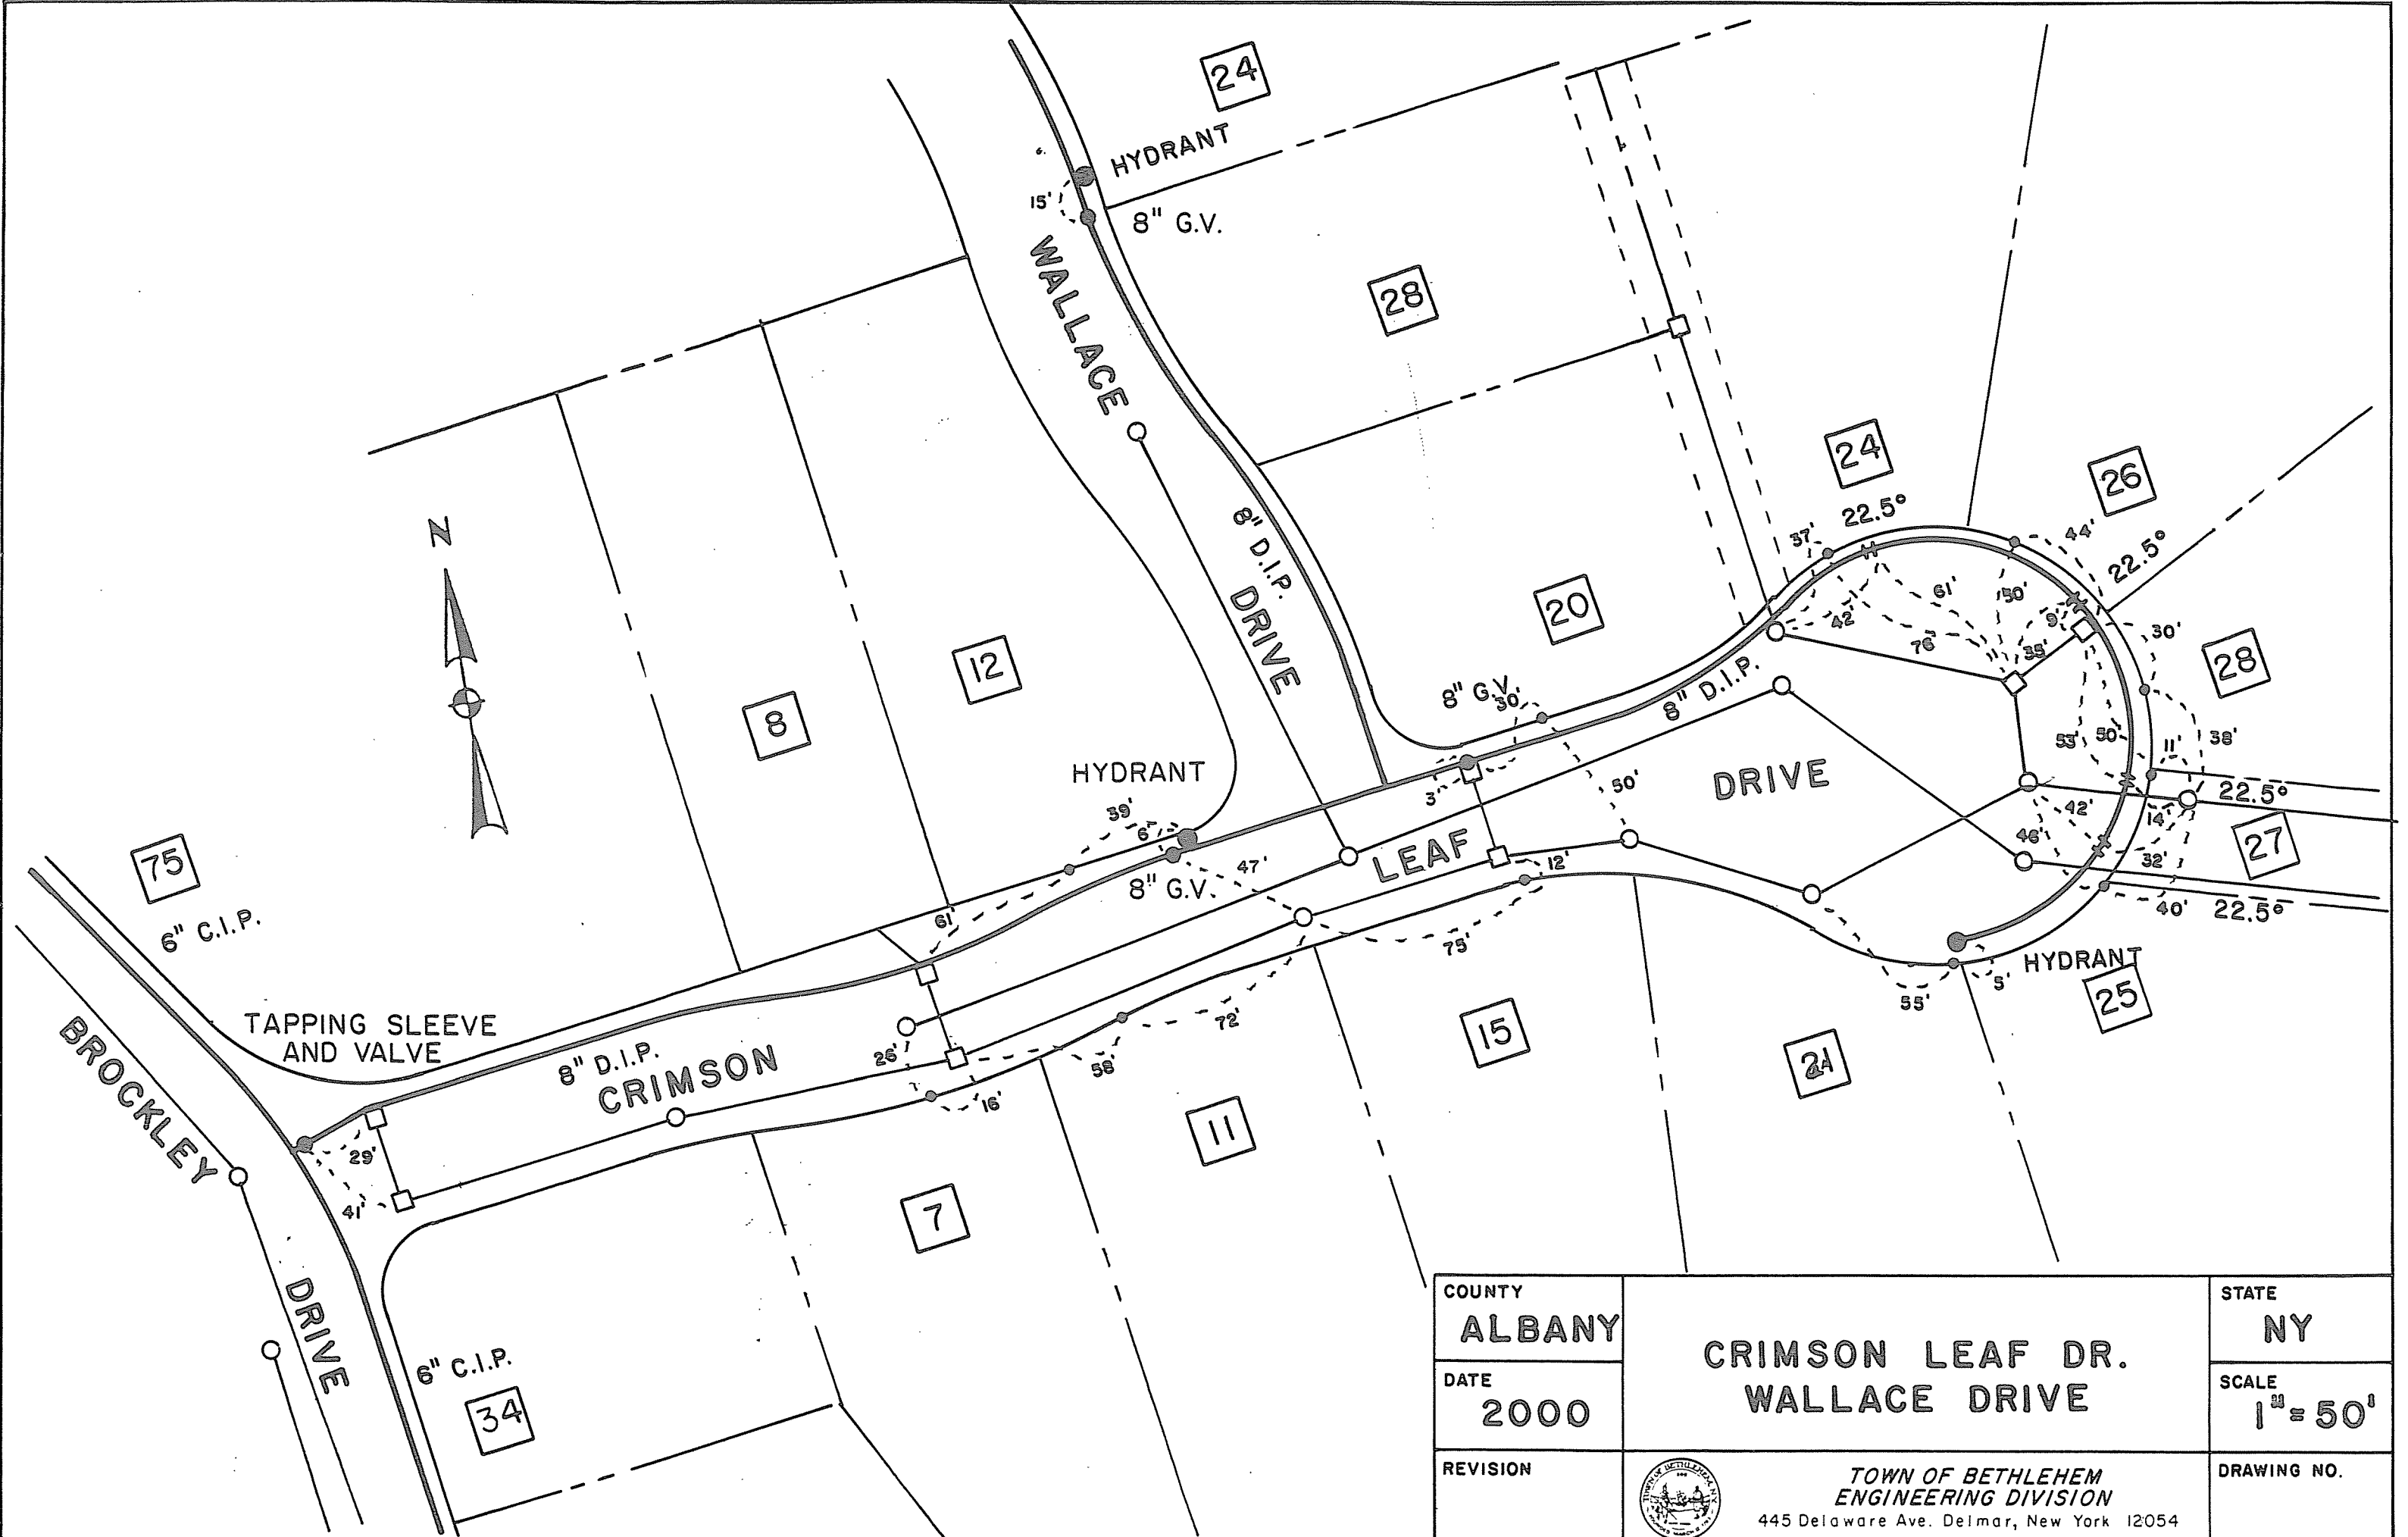

COUNTY	ALBANY
DATE	2000
REVISION	

CRIMSON LEAF DR. WALLACE DRIVE		STATE NY
		SCALE 1" = 50'
 TOWN OF BETHLEHEM ENGINEERING DIVISION 445 Delaware Ave. Delmar, New York 12054		DRAWING NO.

577650