


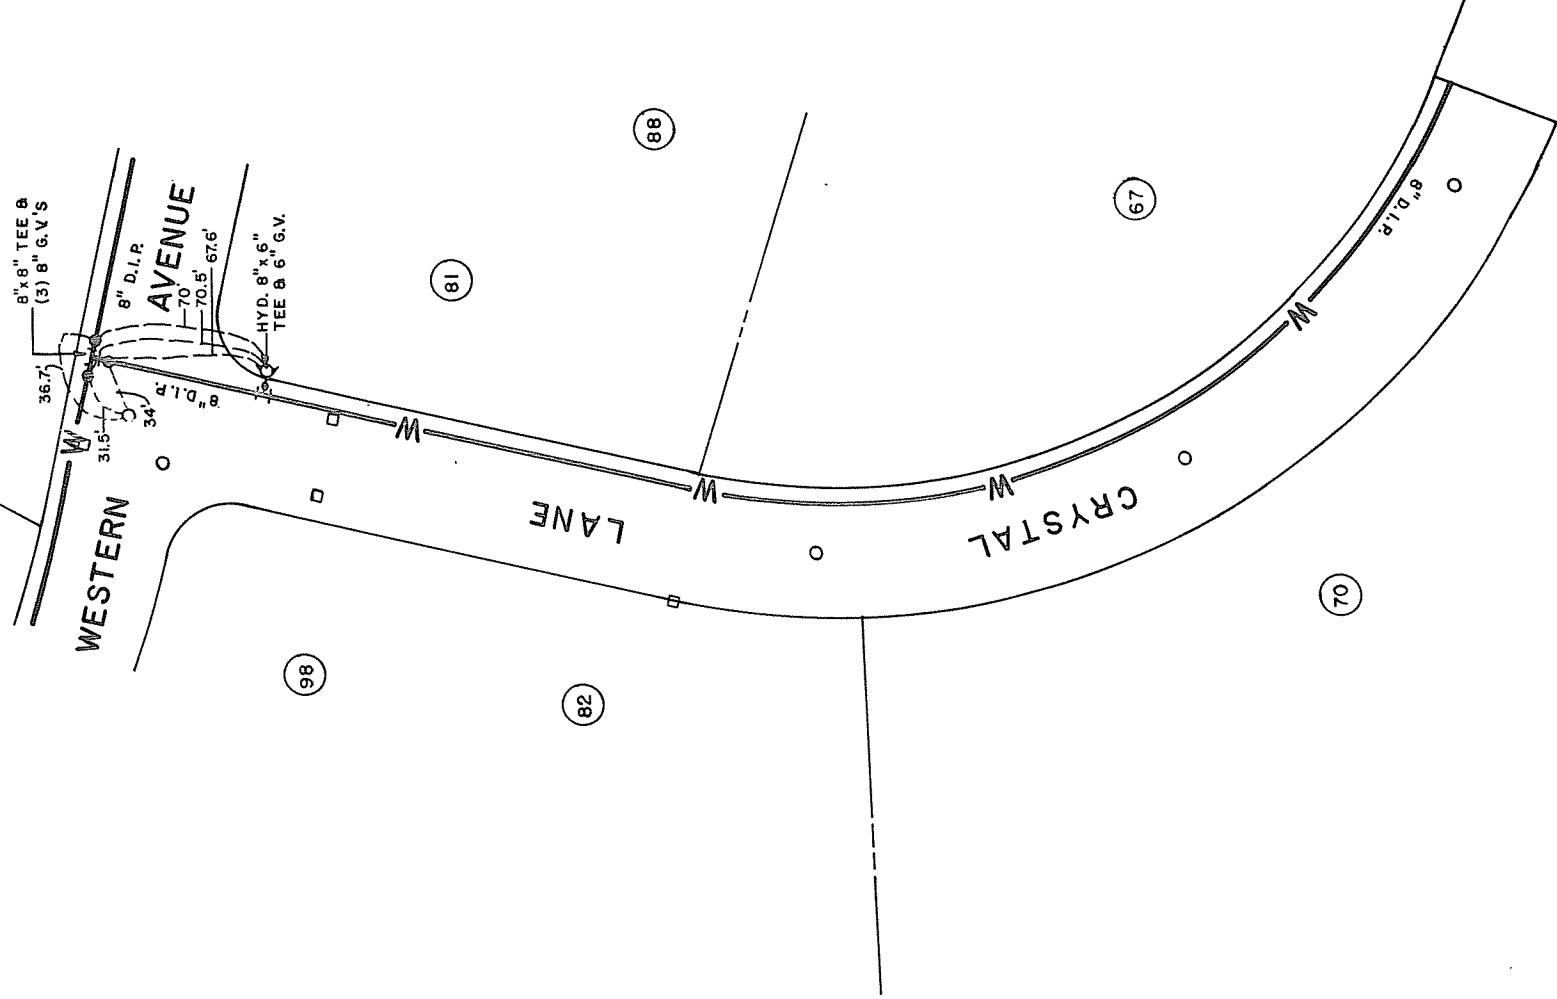

CRYSTAL LANE WATER MAIN

JUNE 1992 RECORD
 SCALE: 1" = 50' DRAWING
 CONSTRUCTED BY LAW
 EXCAVATION CO., INC.
 DRAWN BY M.G.
 CHECKED BY C.W.

Drawn by M.G. 11.11.92