


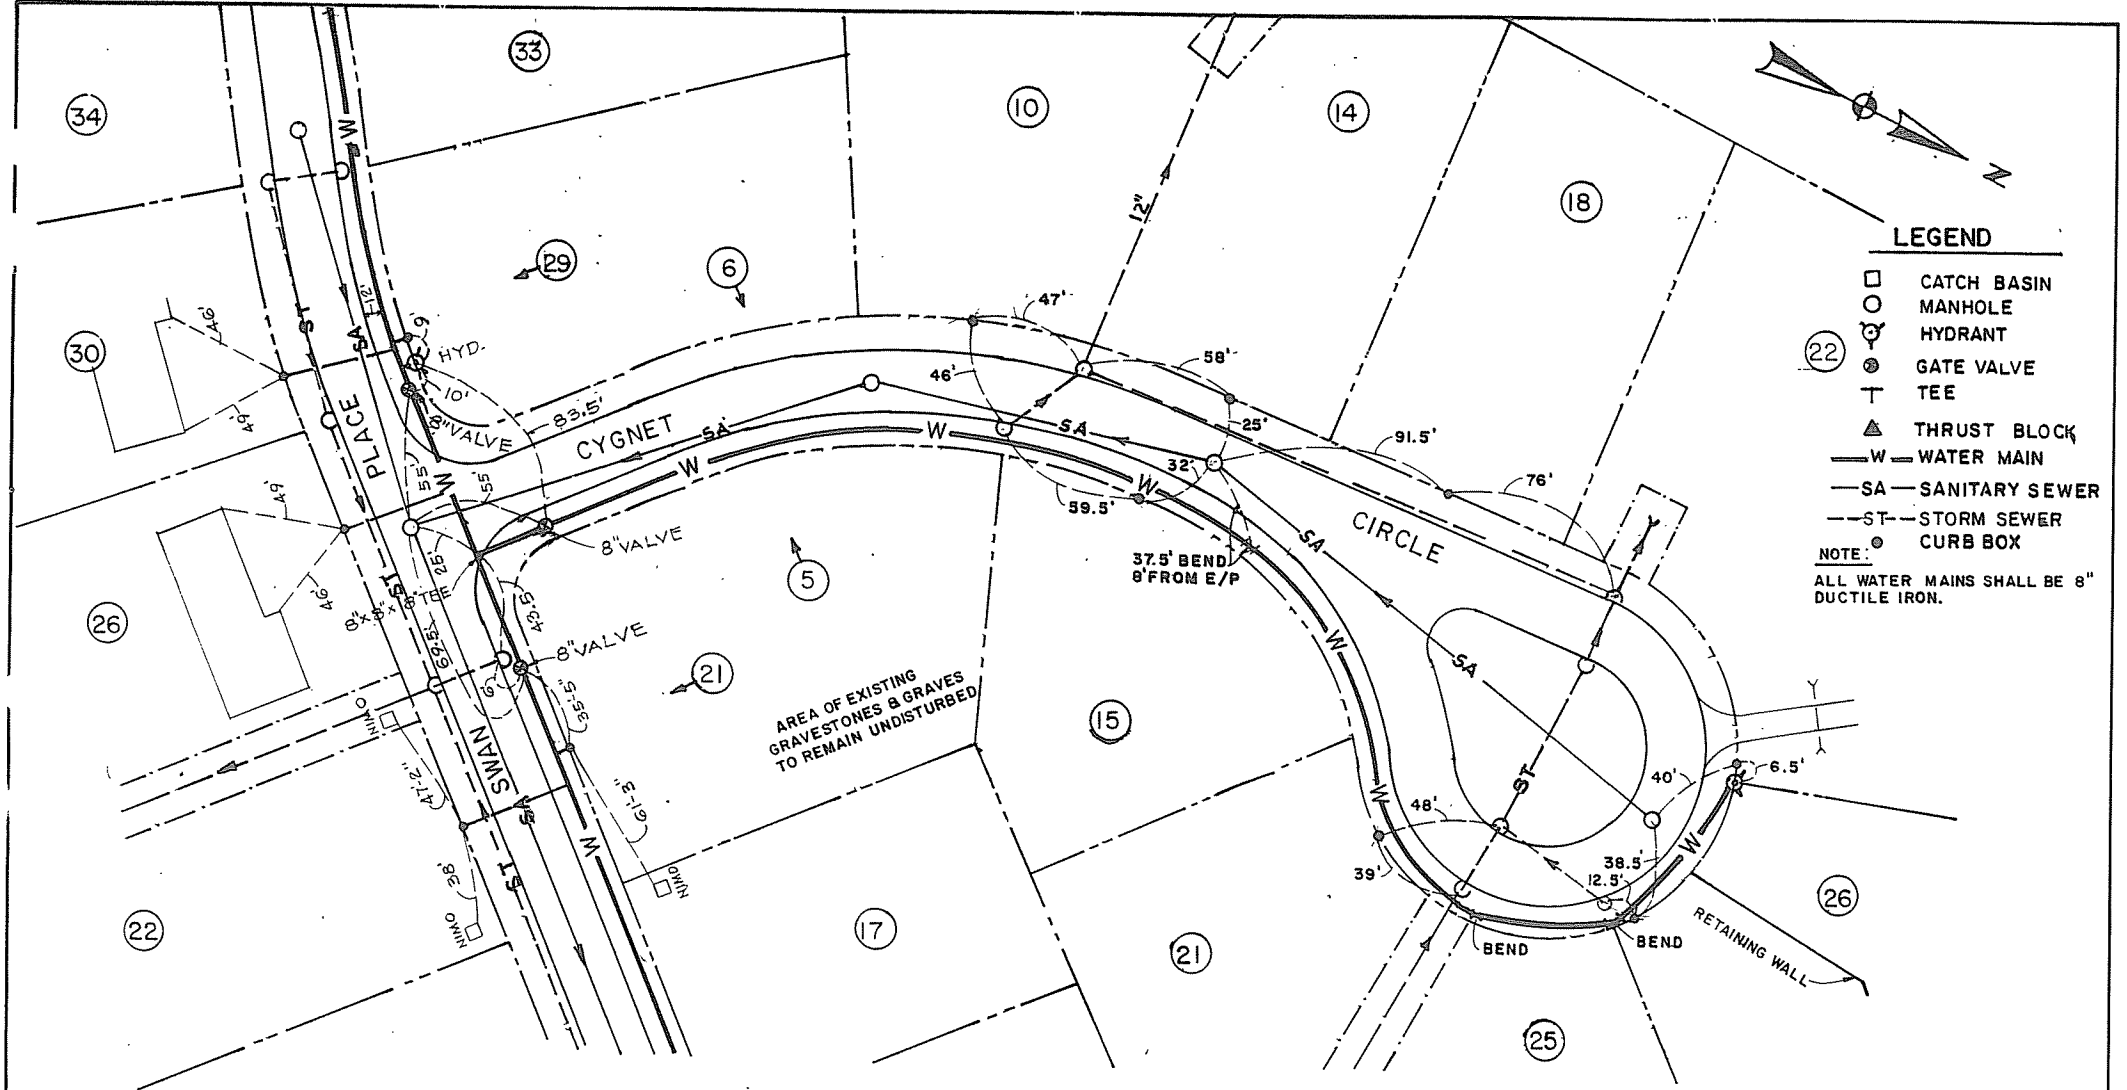

COUNTY ALBANY	CYGNET CIRCLE WATER MAIN FISHER HOLLOW CONTRACTOR: SCHULTZ	STATE NEW YORK
DATE JUNE 26, 1998		SCALE 1" = 50'
REVISION		DRAWING NO.



TOWN OF BETHLEHEM
 ENGINEERING DIVISION
 445 Delaware Ave. Delmar, New York 12054

FISHER HOLLOW